IREDELL COUNTY HEALTH DEPARTMENT

STATESVILLE 704-878-5305 MOORESVILLE 704-664-5281

IMPROVEMENT PERMIT / AUTHORIZATION TO CONSTRUCT / OPERATION PERMIT / EXISTING SYSTEM INSPECTION

PERMIT# 083089 PIN# 4789 53 1335 (PT) DATE 8-4-99

OWNER OR CONTRACTOR PATRICK TURNER PHONE: Business Home 546-2448

ADDRESS 470 RIMROCK ROAD, STATESVILLE, NC 28625

LOCATION I-77 N, TR NC901, TR RIMROCK ROAD, 1.1 MILE ON LEFT BEHIND BOX #470

SUBDIVISION BLOCK / SECTION LOT LOT AREA NOT DEEDED YET SITE CLASS PS DESIGN FLOW 360 L.T.A.R. 0.30 gpd/ft²

Septic Tank: 1000 Gallons; STB 760 Date 6-13-99

Pump Tank: Gallons; PT Date

Pump Make: Model Serial No.

Nitrification Field: No Fields 1 Square Feet 1200 Linear Feet 400

No Lines FOUR Trench Width 36" Max Trench Bottom Depth 32" Gravel Depth 12"

☑ New System ☐ Repair System Type: I II III IV V VI

System Description: CONVENTIONAL GRAVITY

Repair System Description: CONV. GRAVITY

Maintenance Agreement Required: ☐ Yes ☑ No

☐ Slab ☑ Crawl Space ☐ Basement w/plumbing ☐ Basement wo/plumbing

☐ House/Mod. Home No. Bedrooms 3

☑ Mobile Home No. Bathrooms 2

☐ Business No. Employees


☐ Other

Water Supply: ☐ Individual ☑ Public ☐ Community


Comments/Conditions: KEEP SYSTEM MINIMUM 10 FEET FROM PROPERTY LINE - DEED NOT RECORDED YET

Comments/Conditions

INITIAL SITE SKETCH

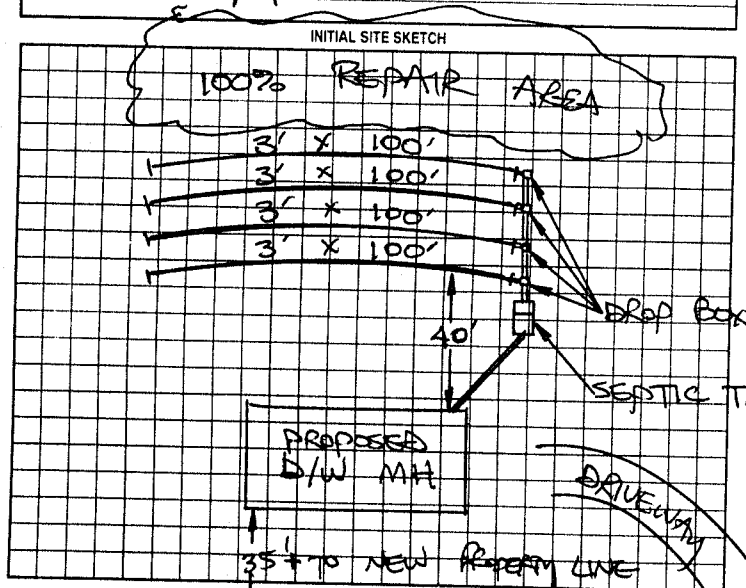

AS BUILT SKETCH

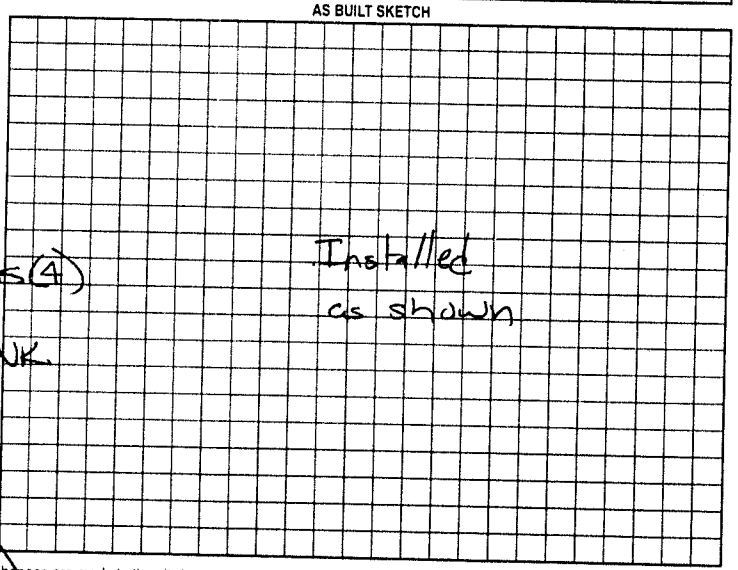

Permit can be suspended or revoked if any false information is supplied toward securing the permit/any unauthorized changes are made to the site/any unauthorized changes are made in the installation of the system. Improvement Permit with plat valid without expiration. Improvement Permit with site plan valid for sixty months. Authorization to Construct is valid for a period equal to that of Improvement Permit – not to exceed sixty months.

Signed: Patrick S Turner date 8-4-99

Improvement Permit by: STEVE HEDRICK date 8-4-99

Authorization to Construct by: STEVE HEDRICK date 8-4-99

Installed by: Randy Miller & Son

Operation Permit by: [illegible] date 8-18-99

Existing System Inspection by: date

HEALTH DEPT COPY: WHITE OWNER COPY (FINAL): YELLOW OWNER COPY (INITIAL): PINK