# IREDELL COUNTY HEALTH DEPARTMENT - *ENVIRONMENTAL HEALTH* ☑ STATESVILLE OFFICE 704-878-5305 ☐ MOORESVILLE OFFICE 704-664-5281

## IMPROVEMENT PERMIT / AUTHORIZATION TO CONSTRUCT / OPERATION PERMIT / EXISTING SYSTEM INSPECTION

PERMIT # 17296S PIN # 4789613681 DATE 6-28-12

OWNER Johnny Brown APPLICANT: Bobby Anderson PHONE: Home/Cell # 704-546-2273 Business # 704-902-7421

SITE ADDRESS 290 Cartner Rd. OWNER / APPLICANT ADDRESS 239 Kinder Rd. Harmony NC 28634

SITE DIRECTIONS Old Macksville Rd; L on Cartner Rd; Site on Right

SUBDIVISION N/A BLOCK / SECTION N/A LOT # N/A LOT AREA 9.179 DESIGN FLOW 360 gpd L.T.A.R. 0.25

Septic Tank Existing Gallons: STB ____ Date ____

Pump Tank ____ Gallons: P T ____ Date ____

Pump Make ____ Model ____ Serial # ____

No. Nitrification Fields: 1 No. Lines 2 Linear Feet 220

Trench Width 36" Max. Trench Bottom Depth 36" Gravel Depth 12"

☐ New System ☐ Repair ☑ Expansion System Type I (II) III IV V VI

System Description: Conventional - gravity

Repair System Description: Conventional - gravity

Maintenance Agreement Required ☐ YES ☑ NO

☑ GRAVITY ☐ PRESSURE

☐ Residence No. Bedrooms 3

☐ Business No. Persons ____

☐ Other No. Employees ____

☐ Slab ☐ Crawl Space


☐ Basement w/plumbing ☐ Basement w/o plumbing

Water Supply: ☐ Private ☐ Public ☐ Community

Comments / Conditions - Install (2) 110' Conventional lines on contour utilizing serial distribution; An accepted system may also be used.

★ Deaden top two Existing Nitrification lines so that they terminate 5' from shop

INITIAL SITE SKETCH

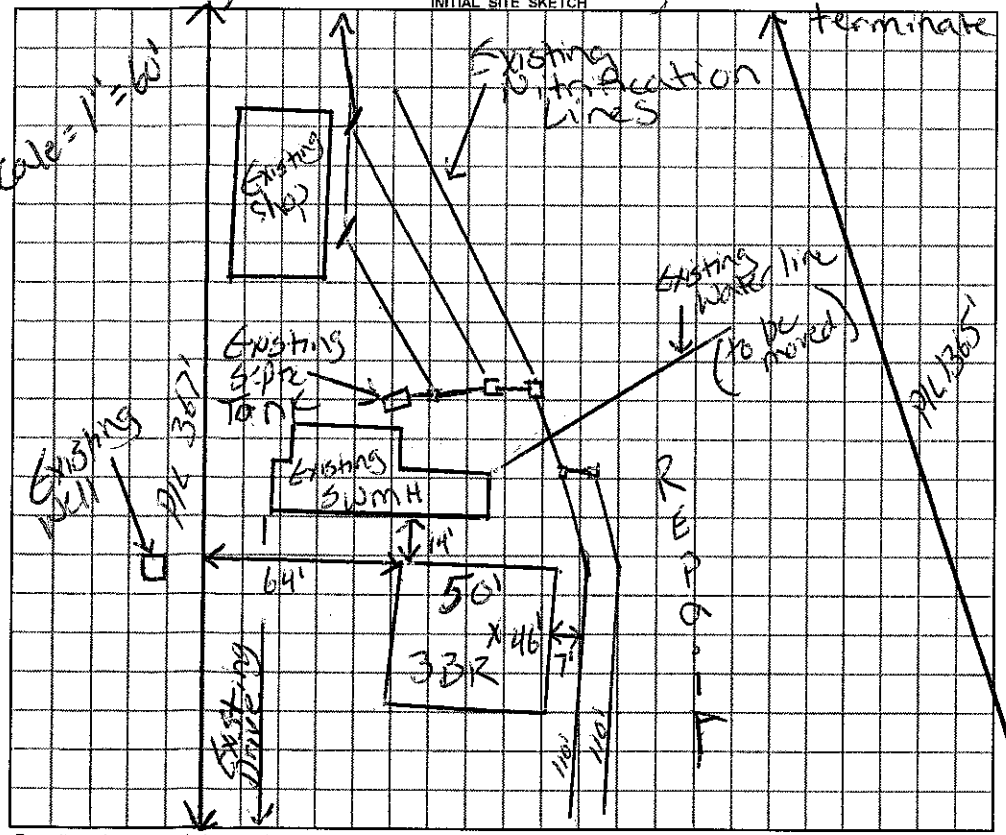


AS BUILT SKETCH

*Permit can be suspended or revoked if any false information is supplied toward securing the permit / any unauthorized changes are made to the site / any unauthorized changes are made in the installation of the system.*

☐ *IMPROVEMENT PERMIT* with plat valid without expiration. ☑ *IMPROVEMENT PERMIT* with plat valid without expiration. *site plan valid 60 mo.* ☑ *AUTHORIZATION TO CONSTRUCT* valid for period equal to IMPROVEMENT PERMIT--not to exceed 60 mo.

Owner / Applicant Signature: Bobby Anderson Date 6-29-12 Installed by: Tommy Frye

IMPROVEMENT PERMIT by: Justin Alexander REHS Date 6-28-12 OPERATION PERMIT by: James REHS Date 12-6-12

AUTHORIZATION TO CONSTRUCT by: Justin Alexander REHS Date 6-28-12 Existing System Inspected by: REHS Date

***YOU SHOULD CONTACT A LOCATOR SERVICE PRIOR TO ANY EXCAVATION***

White Copy – Environmental Health YELLOW COPY (Final) Owner / Applicant PINK COPY (Initial) Owner / Applicant