112131

IREDELL COUNTY HEALTH DEPARTMENT

STATESVILLE 704-878-5305 MOORESVILLE 704-664-5281

CI

IMPROVEMENT PERMIT / AUTHORIZATION TO CONSTRUCT / OPERATION PERMIT / EXISTING SYSTEM INSPECTION

PERMIT# 112131 PIN# 4789-73-~~4587~~ 6421 DATE 4-29-03

OWNER OR CONTRACTOR JOHN & AMANDA SHARPE PHONE: Business Home 704-546-7160

ADDRESS 601 RIMROCK ROAD STATESVILLE, NC 28625

LOCATION US 21 NORTH, TR NC 901, TR RIMROCK ROAD, ON LEFT BEHIND BOX # 602

SUBDIVISION BLOCK / SECTION LOT LOT AREA 3.175 ACRES SITE CLASS PS DESIGN FLOW 360 L.T.A.R. 0.30 GPD/FT²

Septic Tank: 1000 Gallons; STB 1012 Date 2-13-03

Pump Tank: Gallons; PT Date

Pump Make: Model Serial No.

Nitrification Field: No Fields 1 Square Feet 1200 Linear Feet 400

No Lines FIVE Trench Width 36" Max Trench Bottom Depth 36" Gravel Depth 12"

☑ New System ☐ Repair System Type: I, II, III, IV, V, VI

System Description: CONVENTIONAL GRAVITY

Repair System Description: CONVENTIONAL GRAVITY

Maintenance Agreement Required: ☐ Yes ☑ No

☑ House/Mod. Home No. Bedrooms 3

☐ Mobile Home No. Bathrooms 2

☐ Business No. Employees

☐ Other


☐ Slab ☐ Crawl Space ☑ Basement w/plumbing ☐ Basement wo/plumbing

Water Supply: ☐ Individual ☑ Public ☐ Community


Comments/Conditions: INSTALL LINES ON CONTOUR

Comments/Conditions: TUFF TITE FILTER & MARKER BUILDER SPECIFIED OLD HEDGEROW IS ON P/L, WHICH IS 30'+ OFF END OF DRAINLINES. RADIO'ED WITH SEPTIC INSTALLER Tommy Frye'S PHONE.

INITIAL SITE SKETCH SCALE : 1" = 50'

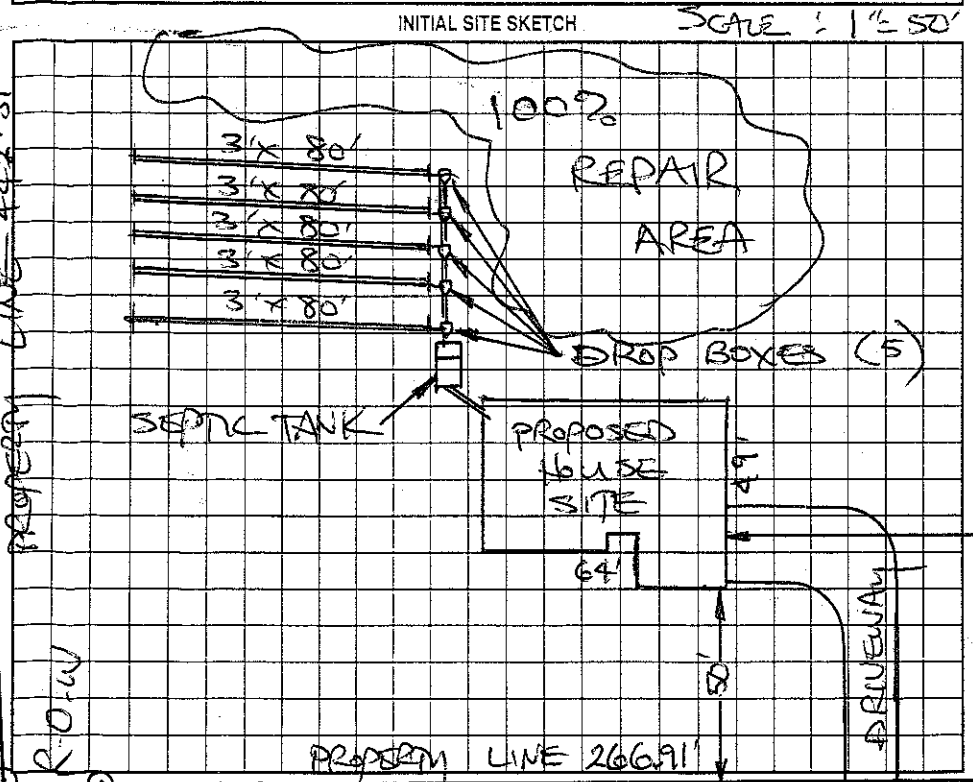

AS BUILT SKETCH

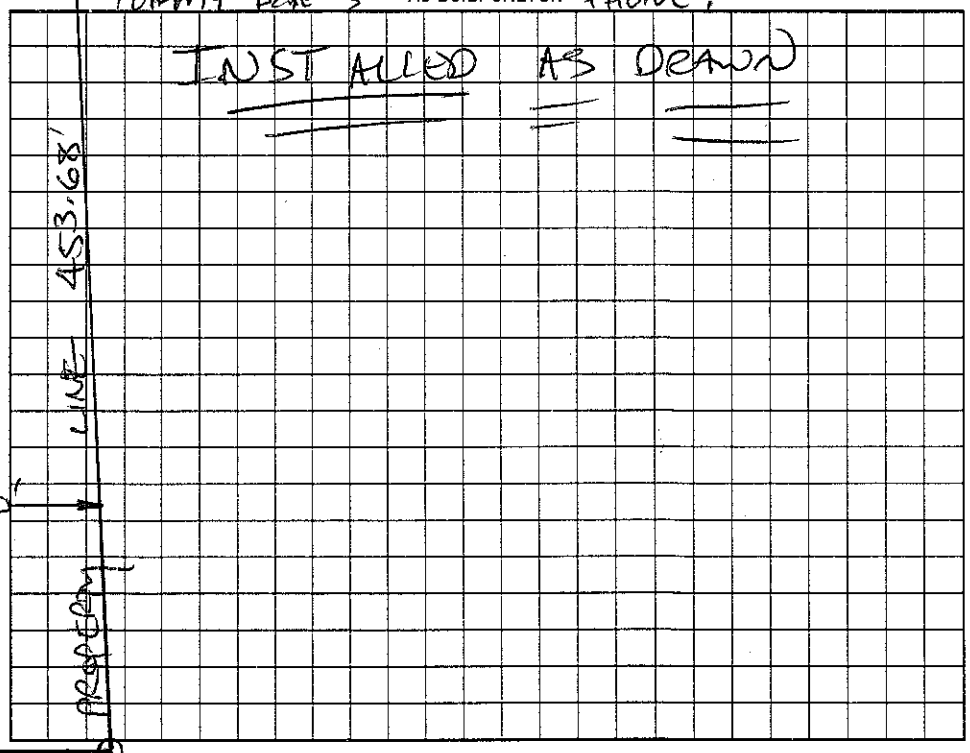

Permit can be suspended or revoked if any false information is supplied toward securing the permit/any unauthorized changes are made to the site/any unauthorized changes are made in the installation of the system. Improvement Permit with plat valid without expiration. Improvement Permit with site plan valid for sixty months. Authorization to Construct is valid for a period equal to that of Improvement Permit – not to exceed sixty months.

Signed: X Amanda J Sharpe date 4/29/03 Installed by: Tommy Frye

Improvement Permit by: STEVE HEDRICK date 4-29-03 Operation Permit by: [signature] date 8-27-03

Authorization to Construct by: STEVE HEDRICK date 4-29-03 Existing System Inspection by: date

HEALTH DEPT. COPY: WHITE OWNER COPY (FINAL): YELLOW OWNER COPY (INITIAL): PINK