IREDELL COUNTY HEALTH DEPARTMENT

STATESVILLE 704-878-5305 MOORESVILLE 704-664-5281

IMPROVEMENT PERMIT / AUTHORIZATION TO CONSTRUCT / OPERATION PERMIT / EXISTING SYSTEM INSPECTION

PERMIT# 91200 PIN# 4789-80-3059 DATE 8-15-00

OWNER OR CONTRACTOR Albert Mullinax PHONE: Business Home 336 492 5481

ADDRESS 1162 carmel cr Apt 130 Casselberry FL

LOCATION 2681 old mocksville Rd 901 East to Rt old mocksville 0.6mi Rt

SUBDIVISION BLOCK / SECTION LOT LOT AREA 21.17 acres SITE CLASS. PS DESIGN FLOW 360 L.T.A.R. .13

Septic Tank: 1000 Gallons; STB 760 Date 5-16-00
Pump Tank: Gallons; PT Date
Pump Make: Model 400 Serial No.
Nitrification Field: No Fields 1 Square Feet Linear Feet 1200
No Lines 5 Trench Width 36" Max Trench Bottom Depth 36" Gravel Depth 12"


☐ New System ☐ Repair System Type: I, II, III, IV, V, VI
System Description: Addition conv. Gravity
Repair System Description:
Maintenance Agreement Required: ☐ Yes ☐ No

☑ House/Mod. Home No. Bedrooms 3
☐ Mobile Home No. Bathrooms 2
☐ Business No. Employees
☐ Other
☐ Slab ☑ Crawl Space ☐ Basement w/plumbing ☐ Basement wo/plumbing

Water Supply: ☐ Individual ☑ Public ☐ Community


Comments/Conditions:

INITIAL SITE SKETCH

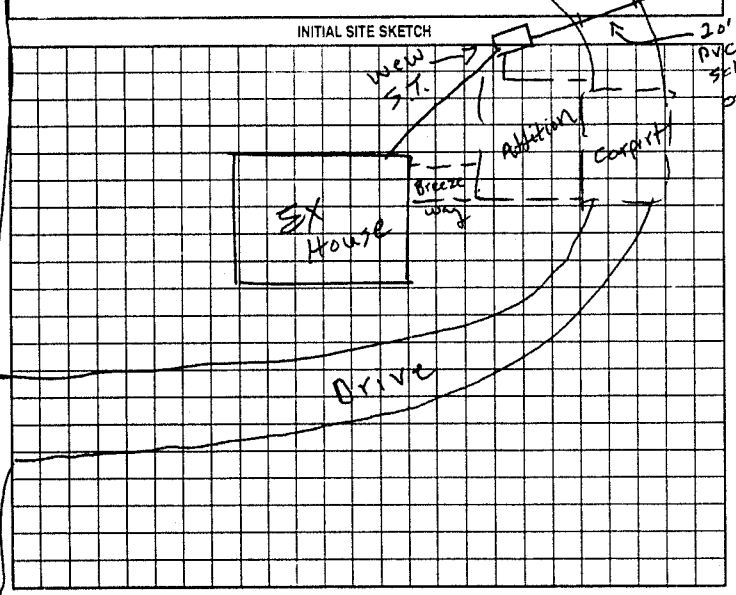

Comments/Conditions: Drop boxes

AS BUILT SKETCH

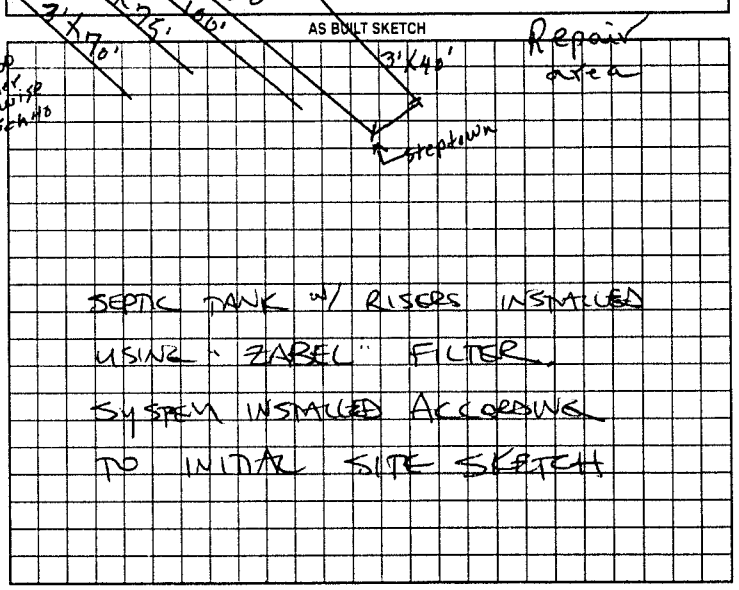

SEPTIC TANK W/ RISERS INSTALLED
USING "ZABEL" FILTER.
SYSTEM INSTALLED ACCORDING
TO INITIAL SITE SKETCH

Permit can be suspended or revoked if any false information is supplied toward securing the permit/any unauthorized changes are made to the site/any unauthorized changes are made in the installation of the system. Improvement Permit with plat valid without expiration. Improvement Permit with site plan valid for sixty months. Authorization to Construct is valid for a period equal to that of Improvement Permit – not to exceed sixty months.

Signed: X [signature] (Builder in law) date 8/15/00 Installed by: SHERMAN DUNN

Improvement Permit by: P.C. Moore date 8-15-00 Operation Permit by: STEVE HENDRICK date 3-1-01

Authorization to Construct by: P.C. Moore date 8-15-00 Existing System Inspection by: date

HEALTH DEPT. COPY: WHITE OWNER COPY (FINAL): YELLOW OWNER COPY (INITIAL): PINK