IREDELL COUNTY HEALTH DEPARTMENT - *ENVIRONMENTAL HEALTH* ☐ STATESVILLE OFFICE 704-878-5305 ☐ MOORESVILLE OFFICE 704-664-5281

IMPROVEMENT PERMIT / AUTHORIZATION TO CONSTRUCT / OPERATION PERMIT / EXISTING SYSTEM INSPECTION

PERMIT # REDAR PIN # 4789-83-9557 DATE DECEMBER 6, 2010

OWNER PARKS M. JONES APPLICANT: PHONE: Home/Cell # Business # 704-546-2510

SITE ADDRESS 6653 RIMROCK ROAD, STATESVILLE OWNER / APPLICANT ADDRESS

SITE DIRECTIONS US 21 NORTH, TR BETHEL RD, TL SHAW RD, TL RIMROCK RD, 1.4 MILES ON RIGHT AT #6653

SUBDIVISION BLOCK / SECTION LOT # LOT AREA 1.2 ACRES DESIGN FLOW 360 L.T.A.R. 0.30 GPD/FT2

Septic Tank 1000 Gallons: STB 760 Date 9-5-0 | ☐ New System ☑ Repair ☐ Expansion System Type I II (III) IV V VI | ☑ Residence No. Bedrooms 3 | Water Supply: ☐ Private ☑ Public ☐ Community

Pump Tank Gallons: P T Date | System Description: 25% REDUCTION, GRAVITY | ☐ Business No. Persons

Pump Make Model Serial # | Repair System Description: | ☐ Other No. Employees


No. Nitrification Fields: 1 No. Lines 3 Linear Feet 300 | Maintenance Agreement Required ☐ YES ☑ NO | ☐ Slab ☐ Crawl Space

Trench Width 36" Max. Trench Bottom Depth 36" Gravel Depth N/A | ☑ GRAVITY ☐ PRESSURE | ☑ Basement w/plumbing ☐ Basement w/o plumbing


Comments / Conditions: ① ABANDON EXISTING SEPTIC TANK & DRAINFIELD ② INSTALL NEW SEPTIC TANK AT LOCATION SHOWN ③ INSTALL NEW DRAINLINES ON CONTOUR AS FLAGGED USING 25% REDUCTION SYSTEM

④ TIE WASHER DRAIN INTO NEW SEPTIC TANK (SEE ATTACHED "NOTICE of VIOLATION")

INITIAL SITE SKETCH

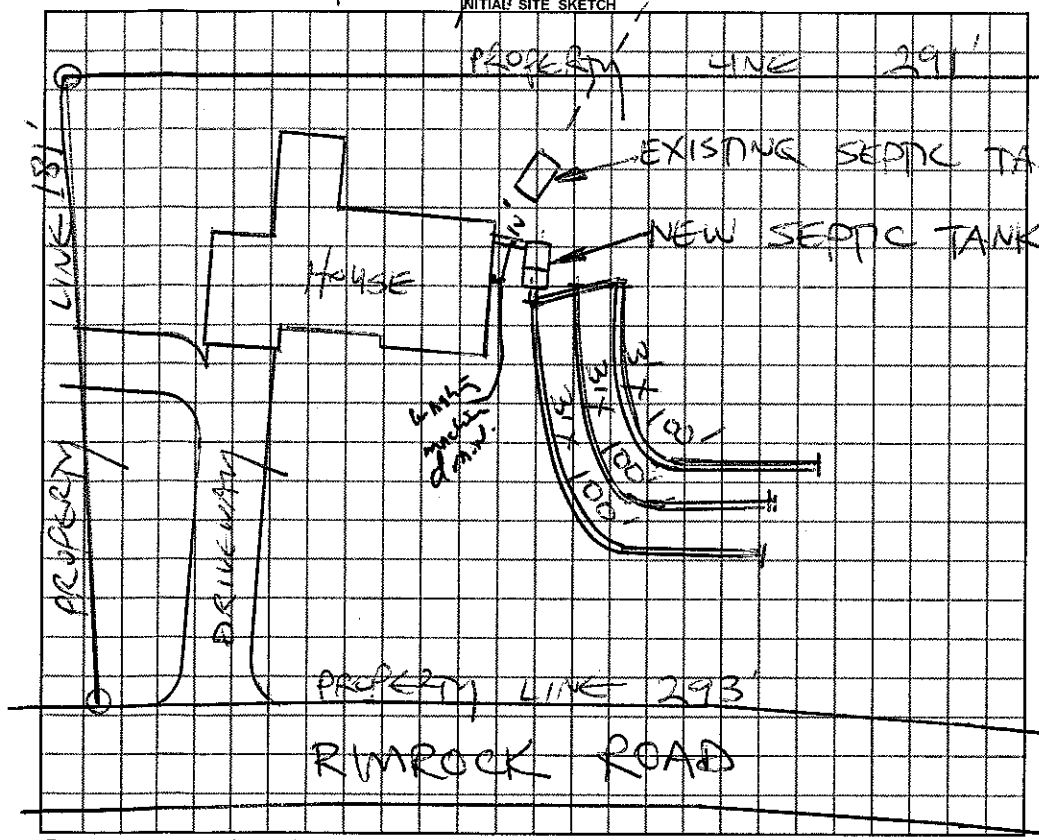

AS BUILT SKETCH

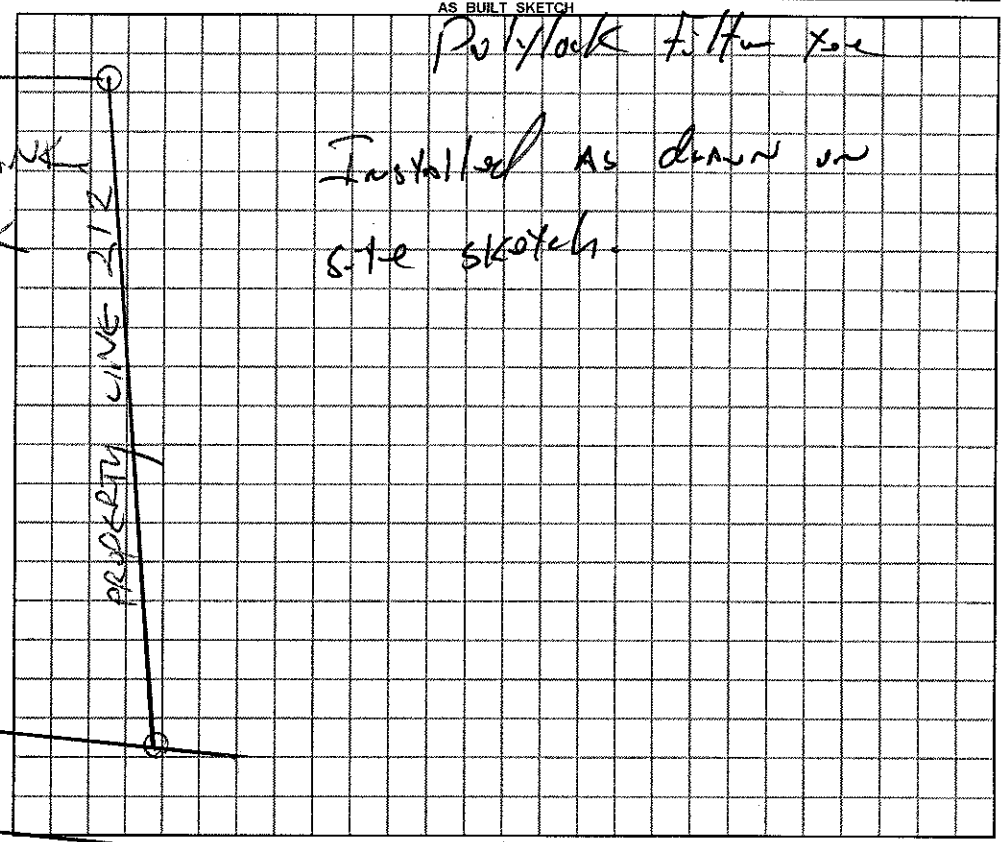

Permit can be suspended or revoked if any false information is supplied toward securing the permit / any unauthorized changes are made to the site / any unauthorized changes are made in the installation of the system.

☐ ***IMPROVEMENT PERMIT*** with plat valid without expiration ☐ ***IMPROVEMENT PERMIT*** with plat valid without expiration. ☑ ***AUTHORIZATION TO CONSTRUCT*** valid for period equal to IMPROVEMENT PERMIT--not to exceed 60 mo.

Owner / Applicant Signature: Parks Jones Date 12-6-2010 Installed by: A-1 Backhoe

IMPROVEMENT PERMIT by: STEVE HEDRICK ***REHS*** Date 12-6-2010 OPERATION PERMIT by: [signature], R.S. ***REHS*** Date 7 Dec 10

AUTHORIZATION TO CONSTRUCT by: STEVE HEDRICK ***REHS*** Date 12-6-2010 Existing System Inspected by: ***REHS*** Date

YOU SHOULD CONTACT A LOCATOR SERVICE PRIOR TO ANY EXCAVATION

White Copy – Environmental Health YELLOW COPY (Final) Owner / Applicant PINK COPY (Initial) Owner / Applicant