IREDELL COUNTY HEALTH DEPARTMENT

Statesville Phone TR 3-7271 Mooresville Phone NO 3-1271

PERMIT TO INSTALL SEPTIC TANK

Permit NO._____ Permit Date Nov 14 1960

Owner Mr Parks Jones Address Harmony R. 2

Installed By Ray F. Long Address Statesville

Location of Property Just East of Statesville


Store on 901 South of Harmony

Tank	Capacity	Length of Lines	Fixtures
Block ( )	800 ( )	150' ( )	No. of Baths (1)
Precast ( )	900 ( )	175' ( )	Dishwasher ( )
Pond	1000 (✓)	200' ( )	Garbage Grdr. ( )
	1100 ( )	225' (✓)	Auto-Washer (✓)
	1200 ( )	250' ( )	Other_____
	Other_____	Other_____	

NOTIFY HEALTH DEPARTMENT AT LEAST EIGHT HOURS BEFORE TANK IS TO BE INSPECTED.

Final Inspection Nov 14 1960 Approved (✓) Disapproved ( )

Remarks Overall

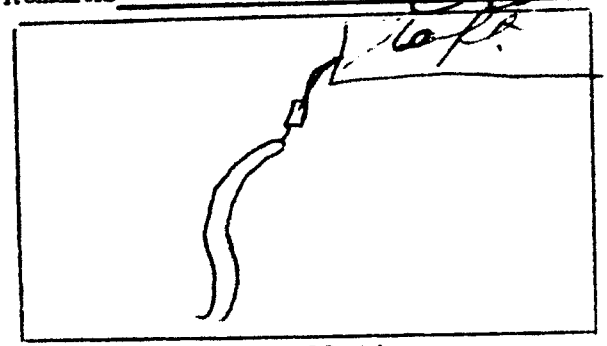

Sketch of Installation

R. A. 2.

Sanitarian