IREDELL COUNTY HEALTH DEPARTMENT

STATESVILLE 704-878-5305 MOORESVILLE 704-664-5281

IMPROVEMENT PERMIT / AUTHORIZATION TO CONSTRUCT / OPERATION PERMIT / EXISTING SYSTEM INSPECTION

PERMIT# 119057 PIN# 4789-92-3263.001 828829 DATE 3/24/04

OWNER OR CONTRACTOR Toby J. Gallihar PHONE: Business 704-546-3190 Home

ADDRESS 678 Rimrock Rd Statesville NC 28625

LOCATION ~~[illegible]~~ (L) 901 (L) Rimrock 1st drive on left

SUBDIVISION BLOCK / SECTION LOT LOT AREA 3.0 ac SITE CLASS. PS DESIGN FLOW 360 L.T.A.R. .25 gpd/ft²

Septic Tank: 1000 Gallons; STB 1012 Date 10-7-04
Pump Tank: Gallons; PT Date
Pump Make: Model Serial No.
Nitrification Field: No Fields 1 Square Feet Linear Feet 480
No Lines 4 Trench Width 36" Max Trench Bottom Depth 24" Gravel Depth 12"

☑ New System ☐ Repair System Type: I, (II), III, IV, V, VI
System Description: Convention gravity
Repair System Description: Pump convention
Maintenance Agreement Required: ☐ Yes ☑ No

☑ House/Mod. Home No. Bedrooms 3
☐ Mobile Home No. Bathrooms 3
☐ Business No. Employees
☐ Other
☐ Slab ☐ Crawl Space ☑ Basement w/plumbing ☐ Basement wo/plumbing


Water Supply: ☐ Individual ☑ Public ☐ Community

Comments:/Conditions: (1) Maintain setbacks (2) Install lines 24" on contour (3) Install according to sketch


Comments:/Conditions: YELLOW "TUFF-TITE" FILTER & MARKER ON TANK

Scale 1" = 100'

INITIAL SITE SKETCH

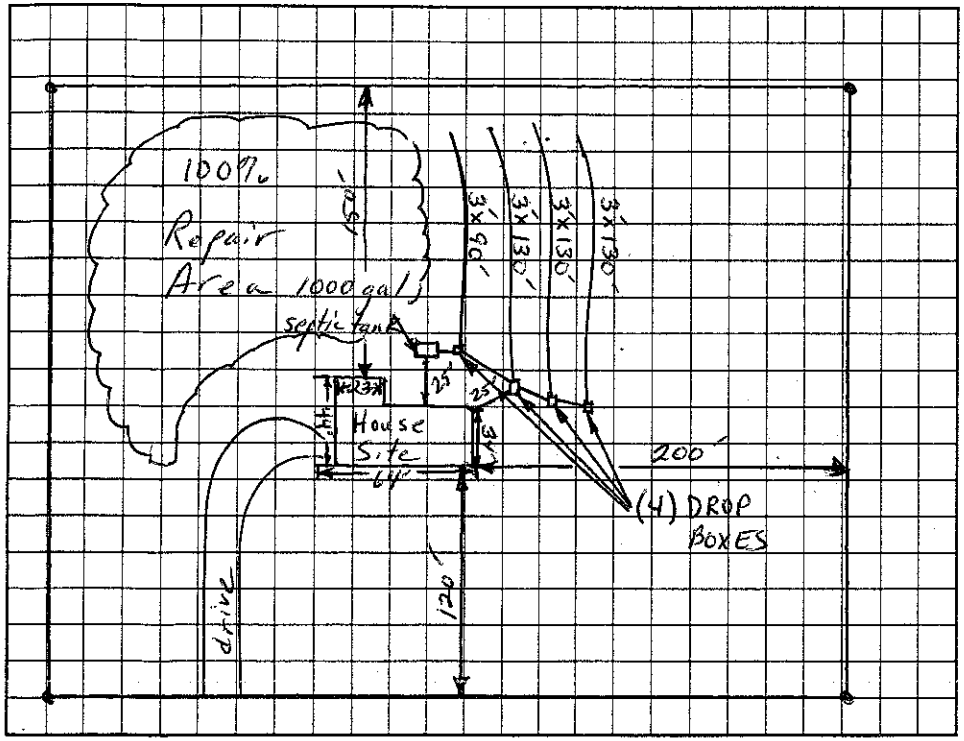

AS BUILT SKETCH

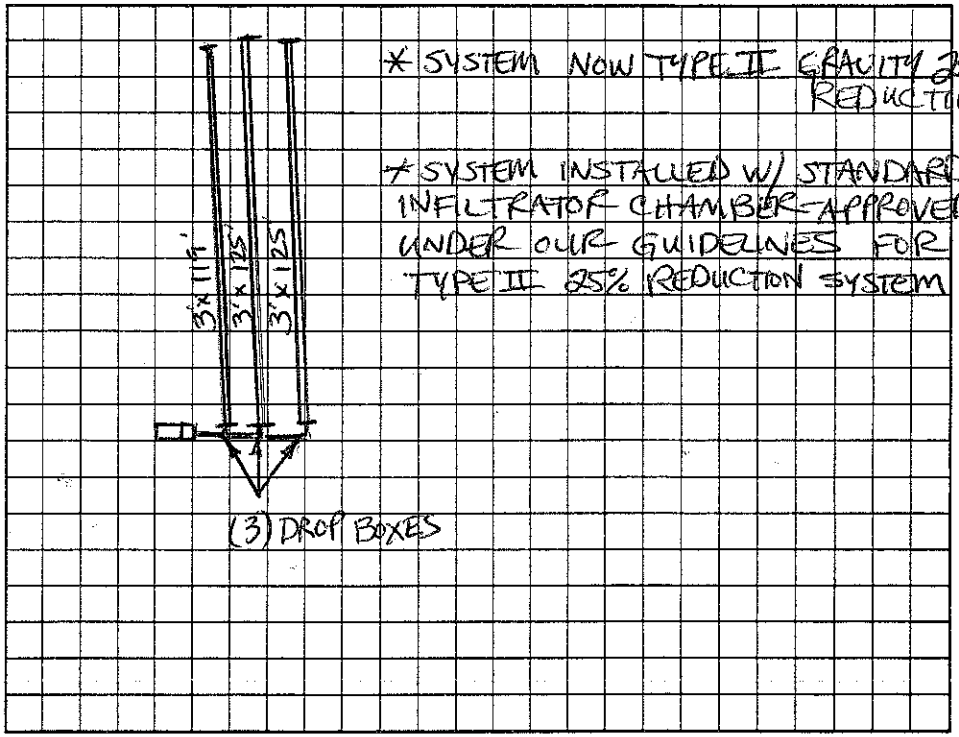

Permit can be suspended or revoked if any false information is supplied toward securing the permit/any unauthorized changes are made to the site/any unauthorized changes are made in the installation of the system. Improvement Permit with plat valid without expiration. Improvement Permit with site plan valid for sixty months. Authorization to Construct is valid for a period equal to that of Improvement Permit – not to exceed sixty months.

Signed: Toby Gallihar date 3-30-04 Installed by: CRAIG THOMPSON

Improvement Permit by: Christopher M. Sherrill RS date 3-24-04 Operation Permit by: Christopher M. Sherrill, RS date 6-21-05

Authorization to Construct by: Christopher M. Sherrill, RS date 3-24-04 Existing System Inspection by: date

HEALTH DEPT. COPY: WHITE OWNER COPY (FINAL): YELLOW OWNER COPY (INITIAL): PINK