IREDELL COUNTY HEALTH DEPARTMENT

STATESVILLE 704-878-5305 MOORESVILLE 704-664-5281

IMPROVEMENT PERMIT / AUTHORIZATION TO CONSTRUCT / OPERATION PERMIT / EXISTING SYSTEM INSPECTION

PERMIT# T25738 PIN# 4789-96-9838 8856 DATE 1/14/05

OWNER OR CONTRACTOR (CLAYTON HOMES - STATESVILLE) PHONE: Business (704) 873-2547 Home

ADDRESS 2026 NORTHSIDE DRIVE STATESVILLE NC 28677

LOCATION I-77N TR HWY 901 (EXIT 65) CROSS 21 GO ~3.5 MILES LOT ON RT @ 998 E. MEMORIAL HWY

SUBDIVISION BLOCK / SECTION LOT LOT AREA 1.62 SITE CLASS PS DESIGN FLOW 360 L.T.A.R. 0.30 gpd/ft²

Septic Tank: 1000 Gallons; STB 1012 Date 7-19-04
Pump Tank: Gallons; PT Date
Pump Make: Model Serial No.
Nitrification Field: No Fields 1 Square Feet 1200 Linear Feet 400'
No Lines 5 Trench Width 36" Max Trench Bottom Depth 24" Gravel Depth 12"

☑ New System ☐ Repair System Type: I (II) III, IV, V, VI
System Description: CONVENTIONAL GRAVITY
Repair System Description: GRAVITY 25% REDUCTION
Maintenance Agreement Required: ☐ Yes ☑ No SHALLOW

☐ House/Mod. Home No. Bedrooms 3
☑ Mobile Home No. Bathrooms
☐ Business No. Employees
☐ Other


Water Supply: ☐ Individual ☑ Public ☐ Community

☐ Slab ☑ Crawl Space ☐ Basement w/plumbing ☐ Basement wo/plumbing


Comments:/Conditions: (1) INSTALL LINES 24" ON CONTOUR MAX
(2) MAINTAIN SETBACKS (3) SMOOTH OUT ROUGH TOPOGRAPHY
(4) REMOVE RED MAPLE TREES FROM DRAINFIELD AREA/REPAIR

Comments:/Conditions: TUFF-TITE FILTER, #5 STONE

INITIAL SITE SKETCH X 1" = 60'

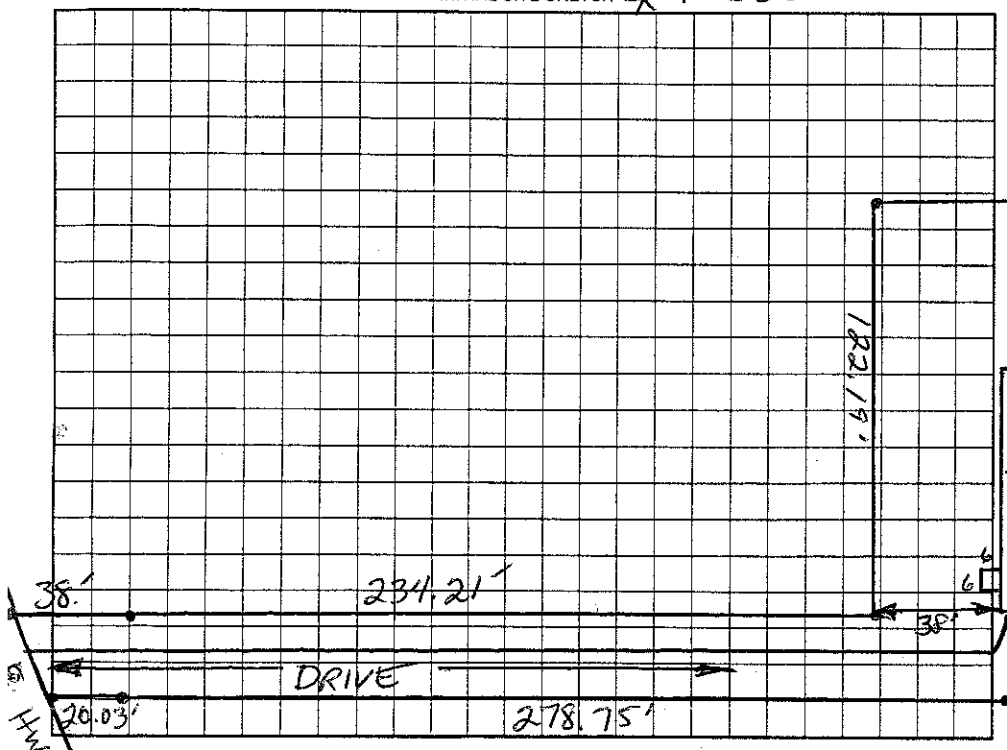

AS BUILT SKETCH

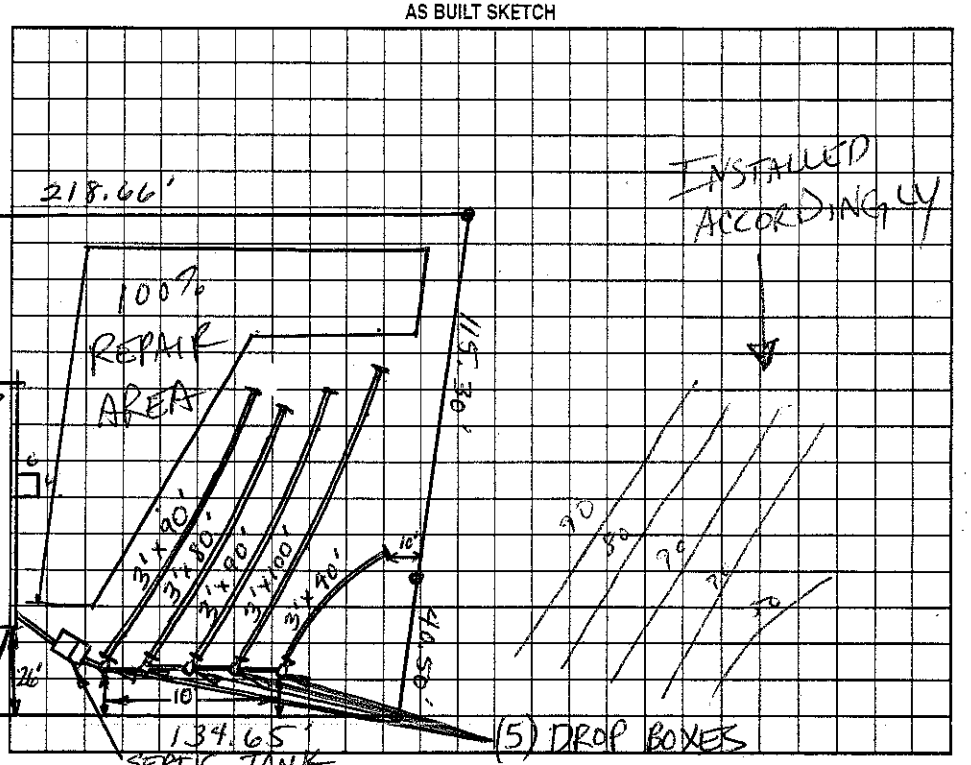

Permit can be suspended or revoked if any false information is supplied toward securing the permit/any unauthorized changes are made to the site/any unauthorized changes are made in the installation of the system. Improvement Permit with plat valid without expiration. Improvement Permit with site plan valid for sixty months. Authorization to Construct is valid for a period equal to that of Improvement Permit – not to exceed sixty months.

Signed: date 1-14-05 Installed by: A-1 BACKHOE

Improvement Permit by: Christopher M. Shields, REHS 1588 date 1-14-05 Operation Permit by: Christopher M. Shields, REHS 1588 date 1-21-05

Authorization to Construct by: Christopher M. Shields, REHS 1588 date 1-14-05 Existing System Inspection by: date

HEALTH DEPT. COPY: WHITE OWNER COPY (FINAL): YELLOW OWNER COPY (INITIAL): PINK