IREDELL COUNTY HEALTH DEPARTMENT

Statesville Phone TR 3-7271 — Mooresville Phone NO 3-1271

PERMIT TO INSTALL SEPTIC TANK

Permit NO. _____ Permit Date 5-12 1967

Owner Pete Patton Address Harmony NC

Installed By Paul Moore Address Harmony NC


Location of Property Hwy 21 N Rt 901 1st house on Rt past Clarksbury Church

Tank		Capacity		Length of Lines		Fixtures	
Block	( )	1000	( )	225'	(✓)	No. of Baths	( )
Precast	( )	1250	( )	250'	( )	Dishwasher	( )
		1500	( )	Other _____		Garbage Grdr.	( )
		Other _____				Other _____	

NOTIFY HEALTH DEPARTMENT AT LEAST EIGHT HOURS BEFORE TANK IS TO BE INSPECTED.

Final Inspection 5-12 1967 Approved (✓) Disapproved ( )

Remarks added 12 ft. of Multification line to end

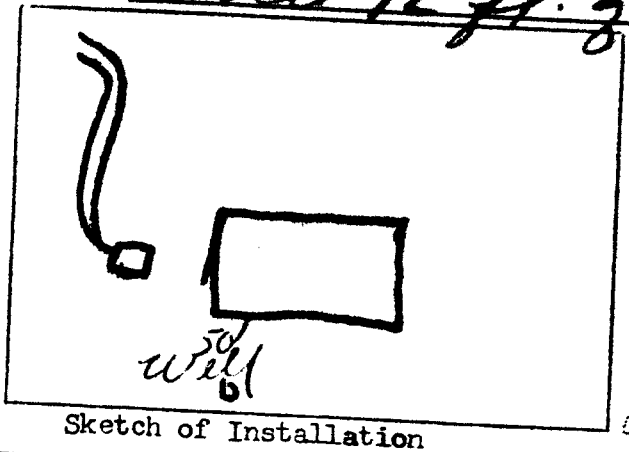

Sketch of Installation

Thomas A. Hutchinson RS
Sanitarian