IREDELL COUNTY HEALTH DEPARTMENT

STATESVILLE 704-878-5305 (C1) MOORESVILLE 704-664-5281

IMPROVEMENT PERMIT / AUTHORIZATION TO CONSTRUCT / OPERATION PERMIT / EXISTING SYSTEM INSPECTION

(C) PERMIT# 108403 PIN# 4789-98-7481 DATE 8-29-02

OWNER OR CONTRACTOR CLARKSBURY UNITED METH. CH. PHONE: Business Home 704-546-7873

ADDRESS 905 E. MEMORIAL HWY, STATESVILLE, NC 28625

LOCATION US 21 N, TR NC 901, ON LEFT JUST BEFORE GUILFORD ROAD

SUBDIVISION BLOCK / SECTION LOT LOT AREA 27.60 ACRES SITE CLASS. PS DESIGN FLOW 480 L.T.A.R. 0.25 GPD/FT²

Septic Tank: 1000 Gallons; STB 760 Date 11-16-02
Pump Tank: Gallons; PT Date
Pump Make: Model Serial No.
Nitrification Field: No Fields 1 Square Feet 1920 Linear Feet 640
No Lines SIX Trench Width 36" Max Trench Bottom Depth 36" Gravel Depth 12"

☑ New System ☐ Repair System Type: I (II) III. IV. V. VI
System Description: CONVENTIONAL GRAVITY
Repair System Description: CONVENTIONAL, GRAVITY
Maintenance Agreement Required: ☐ Yes ☑ No


☑ House/Mod. Home No. Bedrooms 4
☐ Mobile Home No. Bathrooms 3½
☐ Business No. Employees
☐ Other
☐ Slab ☐ Crawl Space ☑ Basement w/plumbing ☐ Basement wo/plumbing

Water Supply: ☐ Individual ☑ Public ☐ Community


Comments:/Conditions: INSTALL SUBSURFACE INTERCEPT DRAINAGE DITCH AT LOCATION SHOWN BEGINNING 48" DEEP, AROUND SYSTEM, THEN OUT TO DAYLIGHT

Comments:/Conditions: (1) SYSTEM ALTERED AS SHOWN BELOW WITH PRIOR HEALTH DEPARTMENT APPROVAL (2) SEPTIC TANK WITH RISERS INSTALLED USING "ZABEL" FILTER

SCALE: 1"=50' INITIAL SITE SKETCH

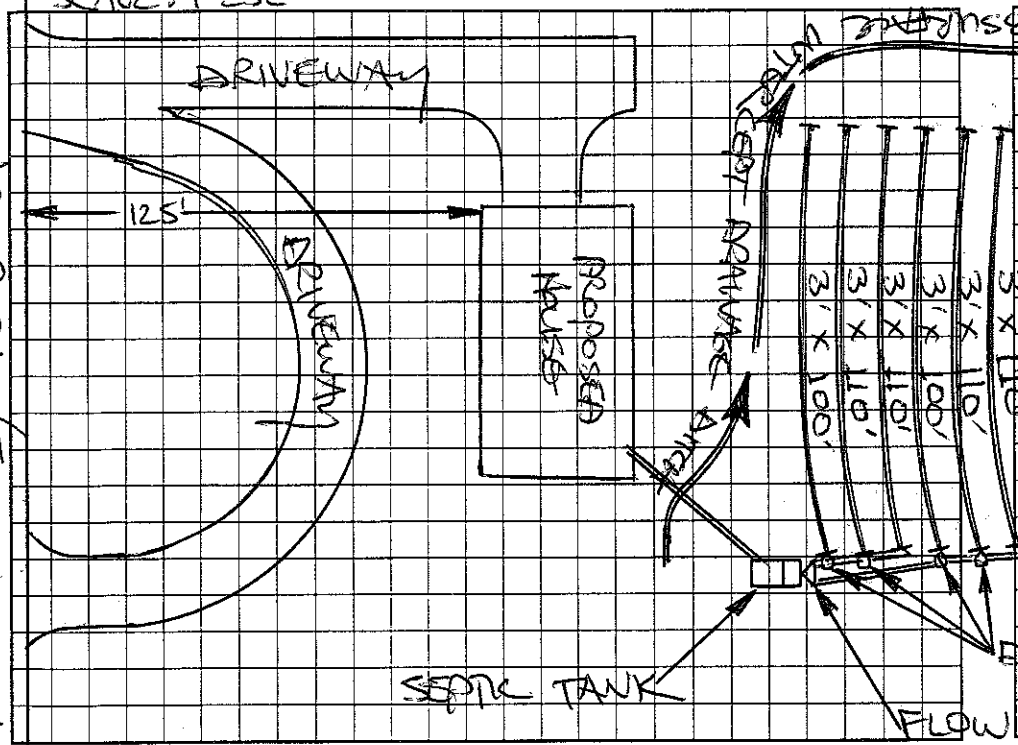

AS BUILT SKETCH

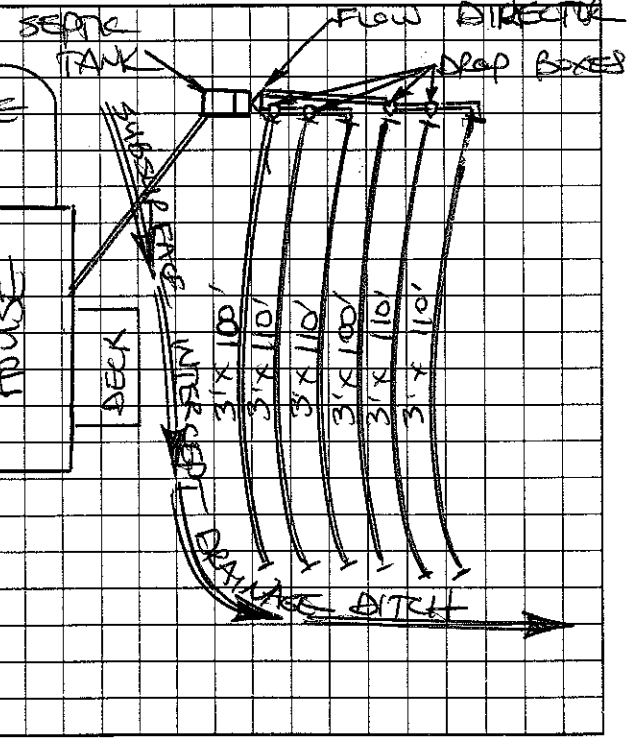

NC 901 (E. MEMORIAL HWY)

Permit can be suspended or revoked if any false information is supplied toward securing the permit/any unauthorized changes are made to the site/any unauthorized changes are made in the installation of the system. Improvement Permit with plat valid without expiration. Improvement Permit with site plan valid for sixty months. Authorization to Construct is valid for a period equal to that of Improvement Permit – not to exceed sixty months.

Signed: Dan Hutchens date 8-29-02 Installed by: BRENT GALLIHER

Improvement Permit by: STEVE HEDRICK date 8-29-02 Operation Permit by: STEVE HEDRICK date 6-25-03

Authorization to Construct by: STEVE HEDRICK date 8-29-02 Existing System Inspection by: date

HEALTH DEPT. COPY: WHITE OWNER COPY (FINAL): YELLOW OWNER COPY (INITIAL): PINK