IREDELL COUNTY HEALTH DEPARTMENT

STATESVILLE 704-878-5305 MOORESVILLE 704-664-5281

IMPROVEMENT PERMIT / AUTHORIZATION TO CONSTRUCT / OPERATION PERMIT / EXISTING SYSTEM INSPECTION

PERMIT# 66910 PIN# 4797-01-3797 AND 4797-01-5824 DATE 1-13-00

OWNER OR CONTRACTOR JAMES DISHMAN PHONE: Business Home 924-8212

ADDRESS 2249 MOCKSVILLE HWY, STATESVILLE, NC 28677

LOCATION US 64E, ON LEFT ~ 0.5 MILE BEFORE S. YADKIN RIVER, ~ 200' BACK OFF ROAD

SUBDIVISION BLOCK / SECTION LOT LOT AREA ~4.5 ACRES SITE CLASS PS DESIGN FLOW 240 L.T.A.R. 0.30 GPD/FT²

Septic Tank: 1000 Gallons; STB 760 Date 11-9-99
Pump Tank: Gallons; PT Date
Pump Make: Model Serial No.
Nitrification Field: No Fields 1 Square Feet EQ. TO 810 Linear Feet EQ. TO 270
No Lines FOUR Trench Width 36" Max Trench Bottom Depth 36"+ Gravel Depth 12"

☑ New System ☐ Repair System Type: I II III IV V VI
System Description: CONVENTIONAL GRAVITY
Repair System Description: CONVENTIONAL PUMP
Maintenance Agreement Required: ☐ Yes ☑ No


☑ House/Mod. Home ☐ Mobile Home ☐ Business ☐ Other
No. Bedrooms 3 No. Bathrooms 2 No. Employees
☐ Slab ☐ Crawl Space ☑ Basement w/plumbing ☐ Basement wo/plumbing

Water Supply: ☑ Individual ☐ Public ☐ Community WELL


Comments/Conditions: ① SYSTEM INSTALLED PRIOR TO ISSUANCE OF VALID PERMIT.
② SYSTEM OPEN DURING PERIOD OF HEAVY RAIN, RESULTING IN 20% LOSS.
③ UPPER MOST LINE INSTALLED AT DEPTH GREATER THAN 36 INCHES.
④ SYSTEM PARTIALLY CAPPED BY FILL MATERIAL.

Comments/Conditions: ⑤ SYSTEM APPROVED FOR TWO BEDROOM USE ONLY.
⑥ SEPTIC TANK WITH "ZABEL" FILTER INSTALLED, WITH TANK MARKER

INITIAL SITE SKETCH

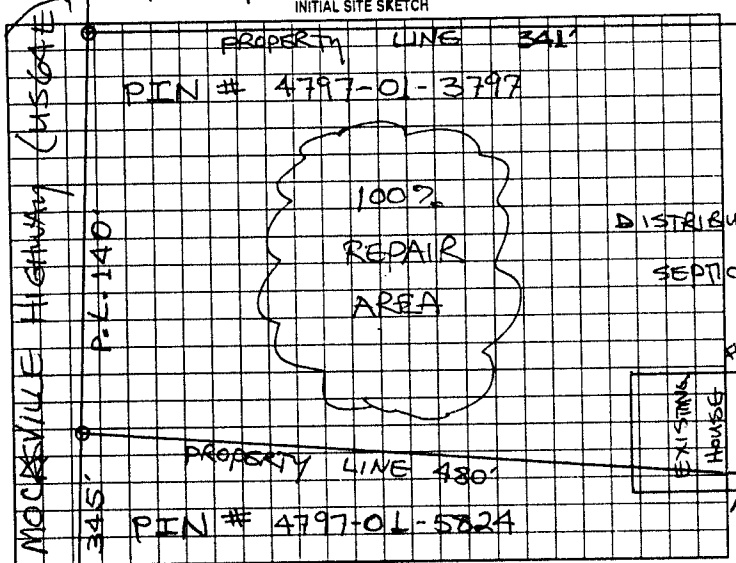

AS BUILT SKETCH

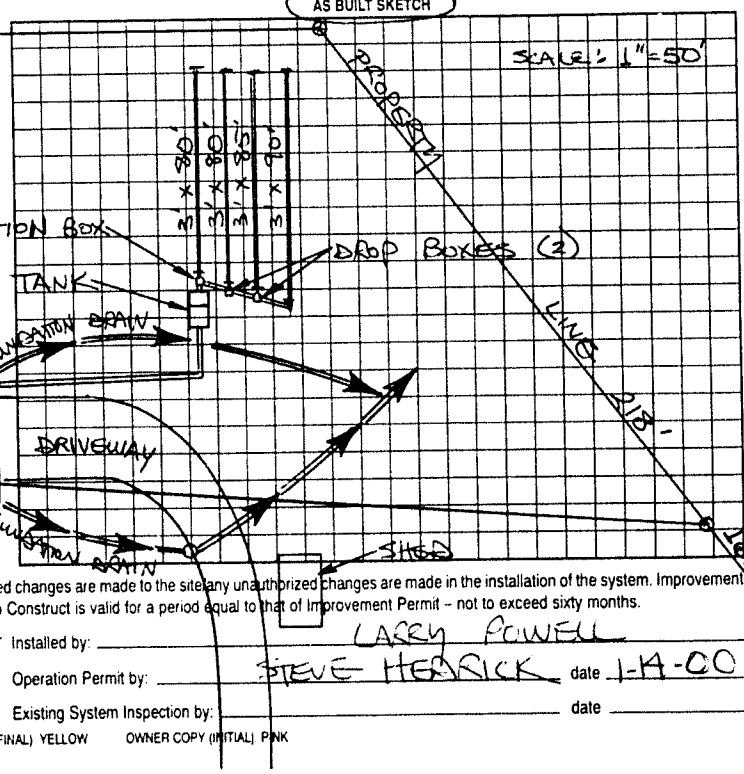

Permit can be suspended or revoked if any false information is supplied toward securing the permit/any unauthorized changes are made to the site/any unauthorized changes are made in the installation of the system. Improvement Permit with plat valid without expiration. Improvement Permit with site plan valid for sixty months. Authorization to Construct is valid for a period equal to that of Improvement Permit – not to exceed sixty months.

Signed: date 1-14-00 Installed by: LARRY FOWELL

Improvement Permit by: STEVE HEDRICK date 1-13-00 Operation Permit by: STEVE HEDRICK date 1-14-00

Authorization to Construct by: STEVE HEDRICK date 1-13-00 Existing System Inspection by: date

HEALTH DEPT COPY: WHITE OWNER COPY (FINAL) YELLOW OWNER COPY (INITIAL) PINK