# IREDELL COUNTY HEALTH DEPARTMENT

STATESVILLE 704-878-5305 MOORESVILLE 704-664-5281

## IMPROVEMENT PERMIT / AUTHORIZATION TO CONSTRUCT / OPERATION PERMIT / EXISTING SYSTEM INSPECTION

CI / CE

PERMIT# 110955 PIN# 4797-06-8931 DATE 02-11-03

OWNER OR CONTRACTOR LEADER HOMES PHONE: Business 336-284-6113 Home 704-662-8436

ADDRESS P.O. BOX 1101 MOORESVILLE, NC 28115

LOCATION 64 EAST, L GARDEN VALLEY RD, CROSS RIVER LOT IS ≈ 1/2 mile on R at LOT # 21

SUBDIVISION SADDLEBROOK BLOCK / SECTION 4 LOT 21 LOT AREA 1.032 AC SITE CLASS. PS DESIGN FLOW 360 L.T.A.R. .3

Septic Tank: 1000 Gallons; STB 5-20-02 Date 1012

Pump Tank: _____ Gallons; PT _____ Date _____

Pump Make: _____ Model _____ Serial No. _____

Nitrification Field: No Fields 1 Square Feet EQ=1100 Linear Feet 300'

No Lines 4X75' Trench Width 36" Max Trench Bottom Depth 36"

☒ New System ☐ Repair System Type: I, II, III, IV, V, VI

System Description: 6 RAW 25% RED

Repair System Description: LP PAVED

Maintenance Agreement Required: ☐ Yes ☒ No

Gravel Depth N/A ☐ Slab ☒ Crawl Space ☐ Basement w/plumbing ☐ Basement wo/plumbing

☒ House/Mod. Home ☐ Mobile Home ☐ Business ☐ Other


No. Bedrooms 3 No. Bathrooms 2 No. Employees _____

Water Supply: ☒ Individual ☐ Public ☐ Community WELL

Comments:/Conditions: (1) SYSTEM IS FLAGGED OUT (2) MARK SIDE P/L WITH NYLON TO MAKE SURE SETBACKS ARE MET (3) INSTALL LINES ON CONTOURS / MAINTAIN SETBACKS (4) KEEP WELL 100' FROM ANY PART OF SYSTEM.

Comments:/Conditions: AT TIME OF FINAL ON SYSTEM, THE PROPERTY LINES WERE MARKED WITH PINK RIBBON. SUPPLY LINE WAS 10' OFF P/L & DRAIN LINES WERE 10' OFF P/L. THIS WAS ACHIEVED BY DRAIN LINES GOING IN AT AN ANGLE.

INITIAL SITE SKETCH

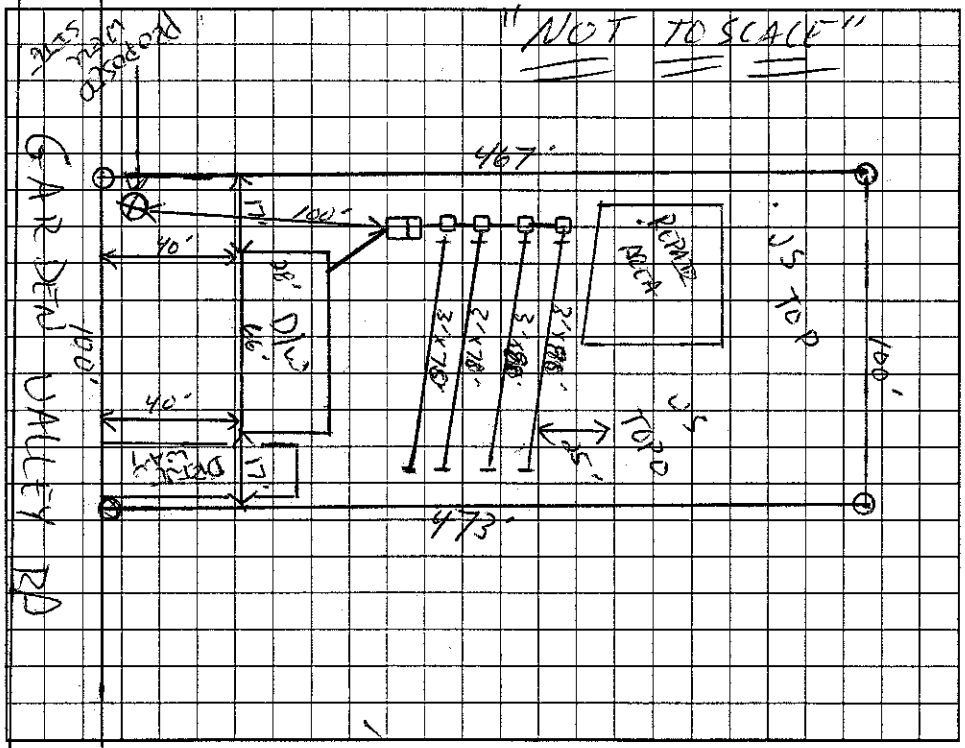


AS BUILT SKETCH

TUFFTITE FILLER & MARKER, E2 FLOW INSTALLED

INSTALLED AS SHOWN

Permit can be suspended or revoked if any false information is supplied toward securing the permit/any unauthorized changes are made to the site/any unauthorized changes are made in the installation of the system. Improvement Permit with plat valid without expiration. Improvement Permit with site plan valid for sixty months. Authorization to Construct is valid for a period equal to that of Improvement Permit – not to exceed sixty months.

Signed: Paul Sprinkle date _____ Installed by: A-1 BACKHOE

Improvement Permit by: L. Cook RS date 02-11-03 Operation Permit by: L. Cook RS date 02-11-03

Authorization to Construct by: L. Cook RS date 02-11-03 Existing System Inspection by: _____ date _____

HEALTH DEPT. COPY: WHITE OWNER COPY (FINAL): YELLOW OWNER COPY (INITIAL): PINK