IREDELL COUNTY HEALTH DEPARTMENT

STATESVILLE 704-878-5305 MOORESVILLE 704-664-5281

IMPROVEMENT PERMIT / CERTIFICATE OF COMPLETION / OPERATION PERMIT / EXISTING SYSTEM INSPECTION

PROPERTY DESCRIPTION NO. 65994 DATE 4-29-97 TAX MAP NO. 4797073602 Watershed: ☐ Yes ☑ No

OWNER OR CONTRACTOR Timothy Lee Doan PHONE: Business Home 704-546-5531

ADDRESS 613 Garden valley Rd

LOCATION 64E TL Battle Rd TL Garden valley Rd 1/2 mi Rt

SUBDIVISION BLOCK / SECTION LOT LOT AREA 1.68 acres SITE CLASS. PS DESIGN FLOW 480 L.T.A. .136

Septic Tank: 1000 Gallons; STB 1012 Date 8-12-97

Pump Tank: Gallons; PT Date

Pump Make: Model Serial No.

Nitrification Field: No Fields 1 Square Feet 1350 Linear Feet 450

No Lines 5 Trench Width 36" Max Trench Bottom Depth 24" Gravel Depth 12"

☑ New System ☐ Repair System Type: I, II, III, IV, V, VI

System Description: Conv. Gravity

Repair System Description:

Maintenance Agreement Required: ☐ Yes ☑ No

☐ House/Mod. Home No. Bedrooms 4

☑ Mobile Home No. Bathrooms 2

☐ Business No. Employees

☐ Other

☐ Slab ☑ Crawl Space ☐ Basement w/plumbing ☐ Basement wo/plumbing


Water Supply: ☑ Individual ☐ Community ☐ Public

Comments:


Comments:

* Landscape so water does not stand over system. - need surface drainage.

INITIAL SITE SKETCH

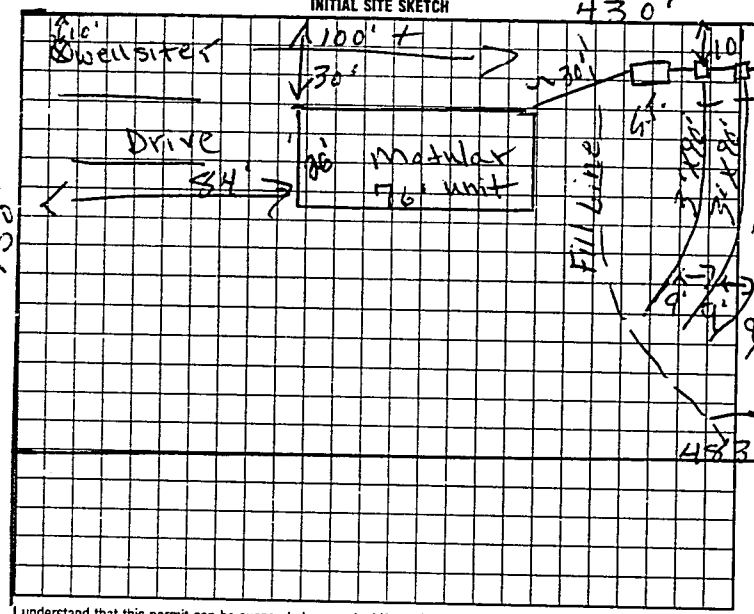

AS BUILT SKETCH

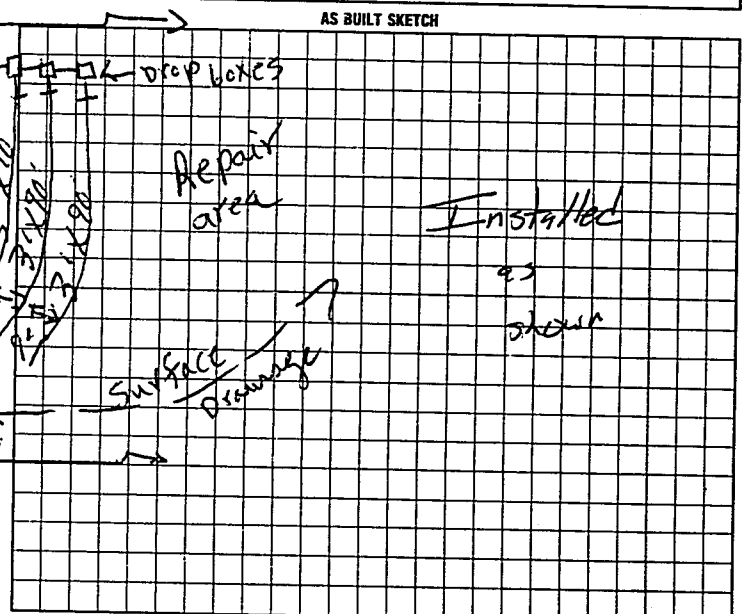

I understand that this permit can be suspended or revoked if any false information is supplied toward securing the permit/any unauthorized changes are made to the site/any unauthorized changes are made in the installation of the system. Improvement Permit is valid for 60 months from date of issuance.

Signed: X

Improvement Permit by: L.C. Moore date 4-29-97

Authorization to Cover Existing System Inspection by: L.C. Moore date 4-29-97

Installed by: Steve Jordan

Certificate of Completion by: date

Operation Permit by: date 10-5-97

HEALTH DEPT. COPY: WHITE INSPECTION COPY (FINAL): GREEN OWNER COPY (FINAL): YELLOW INSPECTION COPY (INITIAL): PINK OWNER COPY (INITIAL): GOLD

Authorization to cover Expires 60 mos from issue