IREDELL COUNTY HEALTH DEPARTMENT

Statesville Office (704) 878-5305 Mooresville Office (704) 660-3625 PERMIT # 180326

IMPROVEMENT PERMIT / AUTHORIZATION TO CONSTRUCT / OPERATION PERMIT / EXISTING SYSTEM

PIN # 4797079909

APPLICANT: Deena Abee APPLICANT ADDRESS: 645 Garden Valley Rd.

SITE ADDRESS: 645 Garden Valley Rd. PHONE: 704-239-3693 ALT. PHONE: N/A

SITE DIRECTIONS: Hwy 64 E TL Cool Springs Rd. TR Garden Valley Rd. Property on Left


SUBDIVISION: N/A SECTION: N/A LOT # N/A LOT AREA: 5.01 acres DESIGN FLOW: 360gpd L.T.A.R.: 0.25

Septic Tank	1000 (gal)	STB	760	Date	8-30-13	☐ New System ☐ Repair ☑ Expansion	System Type: I II III IV V VI	☑ Residence	No. Bedrooms 3
Pump Tank	N/A (gal)	PT	N/A	Date	N/A	System Description:	25% Reduction	☐ Business	No. Persons
Pump Make	N/A	Model	Poly Tank	Serial #	PL-68	Repair System Description:	25% Reduction - Pump	☐ Other	No. Employees
# Nitrification Fields	1	# Lines	4	Linear Ft:	260	Maintenance Agreement Required:	☐ YES ☑ NO	☐ Slab	☑ Crawl Space
Trench Width	36"	Max. Trench Bottom Depth	36"	Gravel Depth	N/A	☑ GRAVITY	☐ PRESSURE	☐ Basement w/plumbing	☐ Basement w/o plumbing

Water Supply: ☑ Private ☐ Public ☐ Community

Comments / Conditions: Install 260' of 25% Reduction system on contour with serial distribution. Connect lowest existing drainline as shown below. Disconnect two upper existing drainlines @ pump & crush existing septic tank. If Poplar tree near existing lower drainline will be removed, DO NOT Remove Stump. Cut tree off at ground and/or grind Stump.

INITIAL SITE SKETCH

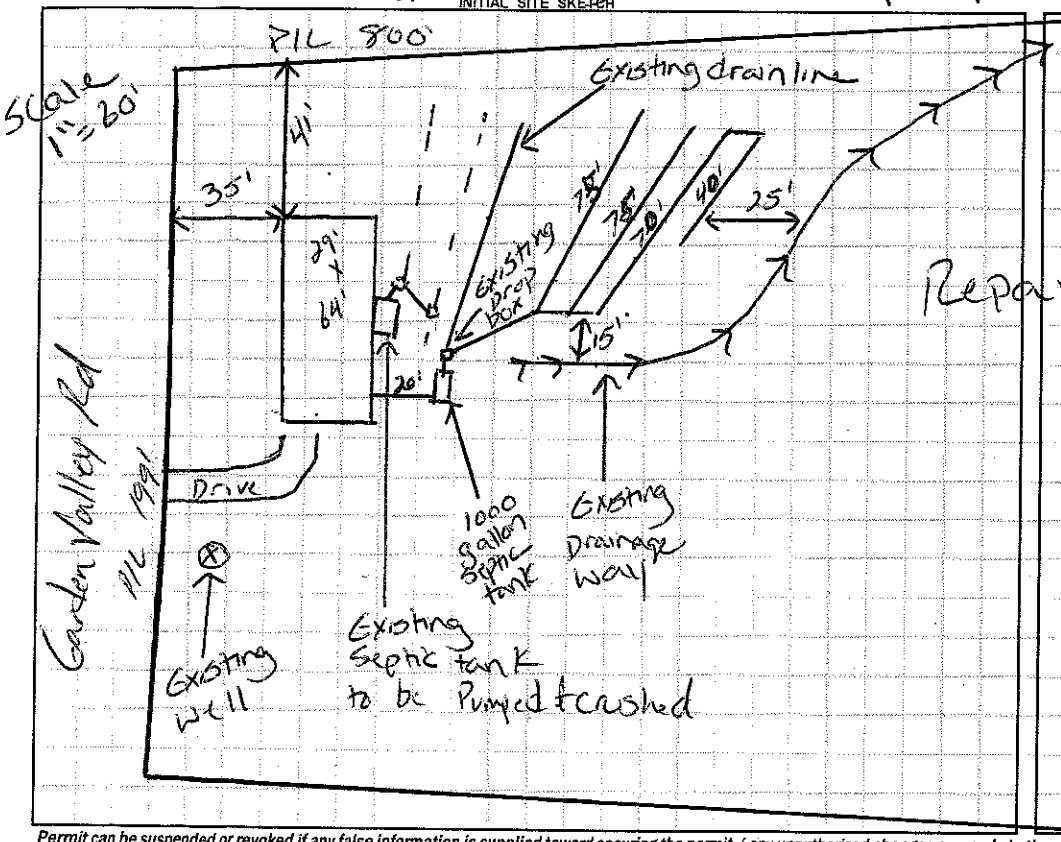

AS BUILT SKETCH

Ads installed as drawn 01/23/14

Permit can be suspended or revoked if any false information is supplied toward securing the permit / any unauthorized changes are made to the site / any unauthorized changes are made in the installation of the system. **CONTACT A LOCATOR SERVICE PRIOR TO ANY EXCAVATION**

☐ **IMPROVEMENT PERMIT** *with plat valid without expiration.* ☑ **IMPROVEMENT PERMIT** *with site plan valid for 60 mos.* ☑ **AUTHORIZATION TO CONSTRUCT** *valid for period equal to IMPROVEMENT PERMIT--not to exceed 60 mo.*

Owner / Applicant Signature: Deena Abee Date: 9/12/13 Installed by: Tim Abee

IMPROVEMENT PERMIT by: Justin Henderson Date: 9-12-13 OPERATION PERMIT by: Date: 01/23/14

AUTHORIZATION TO CONSTRUCT by: Justin Henderson Date: 9-12-13 Existing System Inspected by: Date:

Health Dept. Copy - WHITE Applicant (Final Approval) - YELLOW Applicant (Conditional Approval) - PINK