IREDELL COUNTY HEALTH DEPARTMENT

Authorization to correct

STATESVILLE 704-878-5305 MOORESVILLE 704-664-5281

IMPROVEMENT PERMIT / ~~CERTIFICATE OF COMPLETION~~ / OPERATION PERMIT / EXISTING SYSTEM INSPECTION

PROPERTY DESCRIPTION NO 2323 DATE 2-22-96 TAX MAP NO. 12A-A-41 Watershed: ☐ Yes ☑ No

OWNER OR CONTRACTOR Billy Elmore PHONE: Business Home 872-8850

ADDRESS 267 Locksenhead Rd Sta N.C.

LOCATION 64E TR Cool Spr. Rd TR Garden Valley Cross Yadkin River 1/2 mi left

SUBDIVISION BLOCK / SECTION LOT LOT AREA 5.00 acres SITE CLASS PS DESIGN FLOW 240 L.T.A.R. 1.35 gal/sq ft/day

Septic Tank: 1000 Gallons: STB 794 Date 12-27-95

Pump Tank: Gallons: PT Date

Pump Make: Model Serial No.

Nitrification Field: No Fields 1 Square Feet 690 Linear Feet 230

No Lines 3 Trench Width 36" Max Trench Bottom Depth 36" Gravel Depth 12"

☑ New System ☐ Repair System Type ☐ I ☐ II ☐ III ☐ IV ☐ V

System Description: Conv. Gravity

Repair System Description:

Maintenance Agreement Required ☐ Yes ☑ No

☑ Slab ☐ Crawl Space ☐ Basement w/plumbing ☐ Basement wo/plumbing

☑ House/Mod. Home No. Bedrooms 2

☐ Mobile Home No. Bathrooms 2

☐ Business No. Employees


☐ Other

Water Supply: ☐ Individual ☐ Community ☐ Public

Comments:

Comments

INITIAL SITE SKETCH

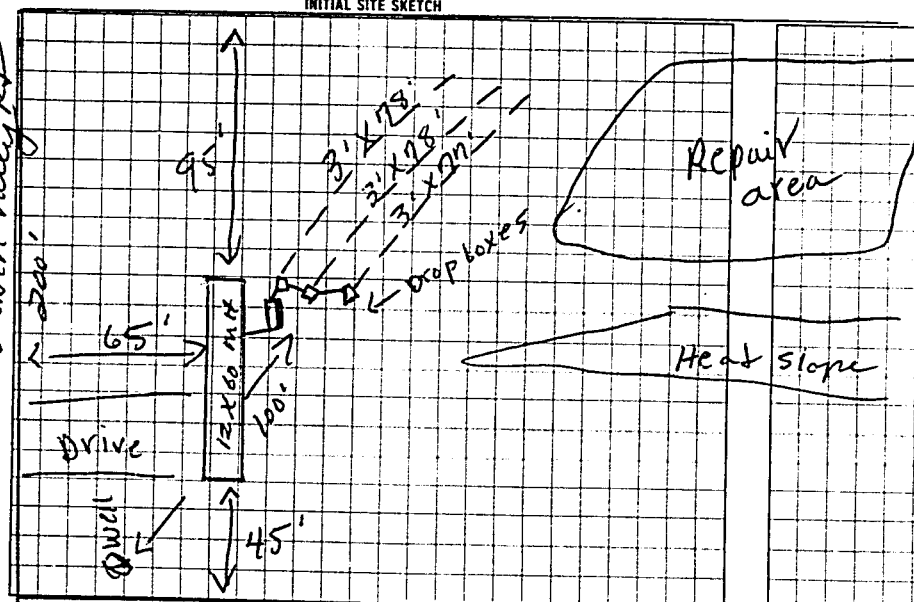

AS BUILT SKETCH

SYSTEM INSTALLED ACCORDING TO INITAL SITE SKETCH

I understand that this permit can be suspended or revoked if any false information is supplied toward securing the permit/any unauthorized changes are made to the site/any unauthorized changes are made in the installation of the system

Signed: X Billy Elmore

Improvement Permit by: L. C. Moore date 2-22-96

~~Existing System Inspection~~ Authorization to correct by: L. C. Moore date 2-22-96

Installed by: A-1 BACKHOE

Certificate of Completion by: date

Operation Permit by: STEVE HEDRICK date 3-14-96

to correct. Expires 60 mos from issue

~~WHITE~~ HEALTH DEPT COPY | INSPECTION COPY (FINAL) GREEN | OWNER COPY (FINAL) YELLOW | INSPECTION COPY (INITIAL) PINK | OWNER COPY (INITIAL) GOLD

090000