IREDELL COUNTY HEALTH DEPARTMENT

STATESVILLE 704-878-5305 MOORESVILLE 704-664-5281

IMPROVEMENT PERMIT / AUTHORIZATION TO CONSTRUCT / OPERATION PERMIT / EXISTING SYSTEM INSPECTION

PERMIT# 24075 8397 PIN# 12A-A-33 Tax map DATE 9-21-99

OWNER OR CONTRACTOR Randy Rodden PHONE: Business Home 546-5785

ADDRESS 675 Garden Valley Rd Statesville 28625

LOCATION 64E TL Garden valley Rd Cross I-40 1/2 mi on left

SUBDIVISION BLOCK / SECTION LOT 3 LOT AREA 33.58 acres SITE CLASS PS DESIGN FLOW 240 L.T.A.R. .13

Septic Tank: 1000 Gallons; STB 760 Date 7799
Pump Tank: Gallons; PT Date
Pump Make: Model Serial No.
Nitrification Field: No Fields 1 Square Feet 900 Linear Feet 300
No Lines 3 Trench Width 36" Max Trench Bottom Depth 36" Gravel Depth 12"

☑ New System ☐ Repair System Type: I II III IV V VI
System Description: Conv. Gravity
Repair System Description: 1C 1L
Maintenance Agreement Required: Yes ☑ No

☐ House/Mod. Home ☑ Mobile Home ☐ Business ☐ Other
No. Bedrooms 2 No. Bathrooms 2 No. Employees


☐ Slab ☑ Crawl Space ☐ Basement w/plumbing ☐ Basement wo/plumbing

Water Supply: ☑ Individual ☐ Public ☐ Community


Comments/Conditions:

Comments/Conditions

INITIAL SITE SKETCH

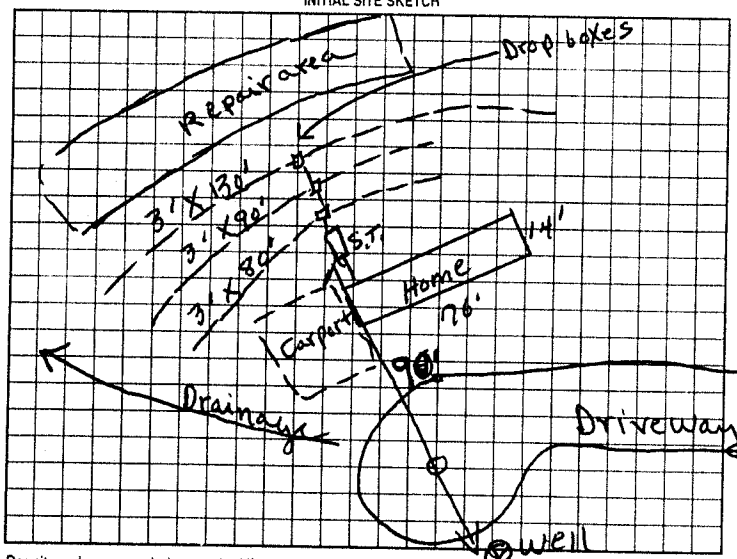

AS BUILT SKETCH

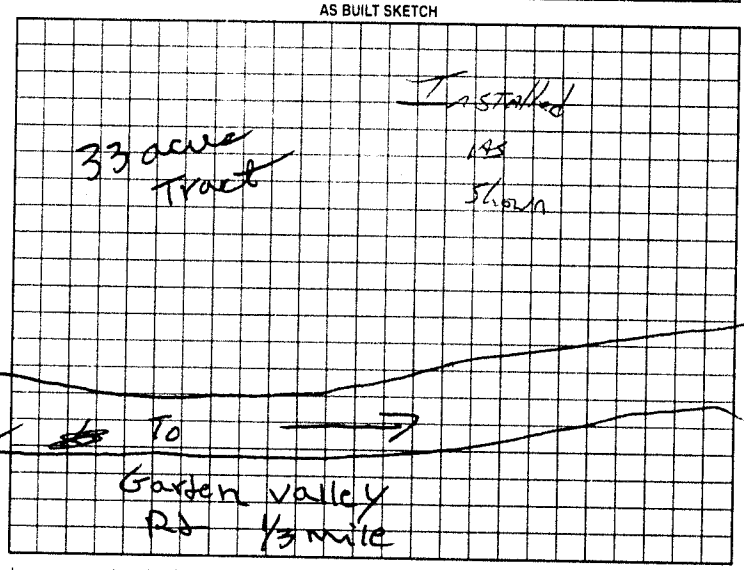

Permit can be suspended or revoked if any false information is supplied toward securing the permit/any unauthorized changes are made to the site/any unauthorized changes are made in the installation of the system. Improvement Permit with plat valid without expiration. Improvement Permit with site plan valid for sixty months. Authorization to Construct is valid for a period equal to that of Improvement Permit - not to exceed sixty months.

Signed: Barbara Rodden date 9-22-99 Installed by: Randy Miller & Son

Improvement Permit by: J. C. Moore date 9-21-99 Operation Permit by: J. Potter date Oct 8 99

Authorization to Construct by: J. C. Moore date 9-21-99 Existing System Inspection by: date

HEALTH DEPT COPY WHITE OWNER COPY (FINAL) YELLOW OWNER COPY (INITIAL) PINK