IREDELL COUNTY HEALTH DEPARTMENT

STATESVILLE 704-878-5305 MOORESVILLE 704-664-5281

IMPROVEMENT PERMIT / CERTIFICATE OF COMPLETION / OPERATION PERMIT / EXISTING SYSTEM INSPECTION

PROPERTY DESCRIPTION NO. 26337 DATE 4-24-97 TAX MAP NO. 4797 17 0102

OWNER OR CONTRACTOR Rodney Braybill Watershed: ☑ Yes ☐ No

ADDRESS 246 Troutman Shoals Rd Sta PHONE: Business ______ Home 528-9593 WSIV PA

LOCATION 64E TL Battle Rd TL Garden Valley 1/4 mi left

SUBDIVISION Saddlebrook BLOCK / SECTION ______ LOT 16 LOT AREA 1.1 acres SITE CLASS. PS DESIGN FLOW 360 L.T.A.R. .33

Septic Tank: 1000 Gallons; STB 1017 Date 10-21-97

Pump Tank: ______ Gallons; PT ______ Date ______

Pump Make: ______ Model ______ Serial No. ______

Nitrification Field: No Fields 1 Square Feet 1080 Linear Feet 360

No Lines 4 Trench Width 36" Max Trench Bottom Depth 36" Gravel Depth 12"

☑ New System ☐ Repair System Type: I, (II), III, IV, V, VI

System Description: Conv. Gravity

Repair System Description: Gravity Chambers

Maintenance Agreement Required: ☐ Yes ☐ No

☐ House/Mod. Home ☑ Mobile Home ☐ Business ☐ Other ______

No. Bedrooms 3 No. Bathrooms 2 No. Employees ______


Water Supply: ☑ Individual ☐ Community ☐ Public

☐ Slab ☑ Crawl Space ☐ Basement w/plumbing ☐ Basement wo/plumbing


Comments:

Comments:

INITIAL SITE SKETCH

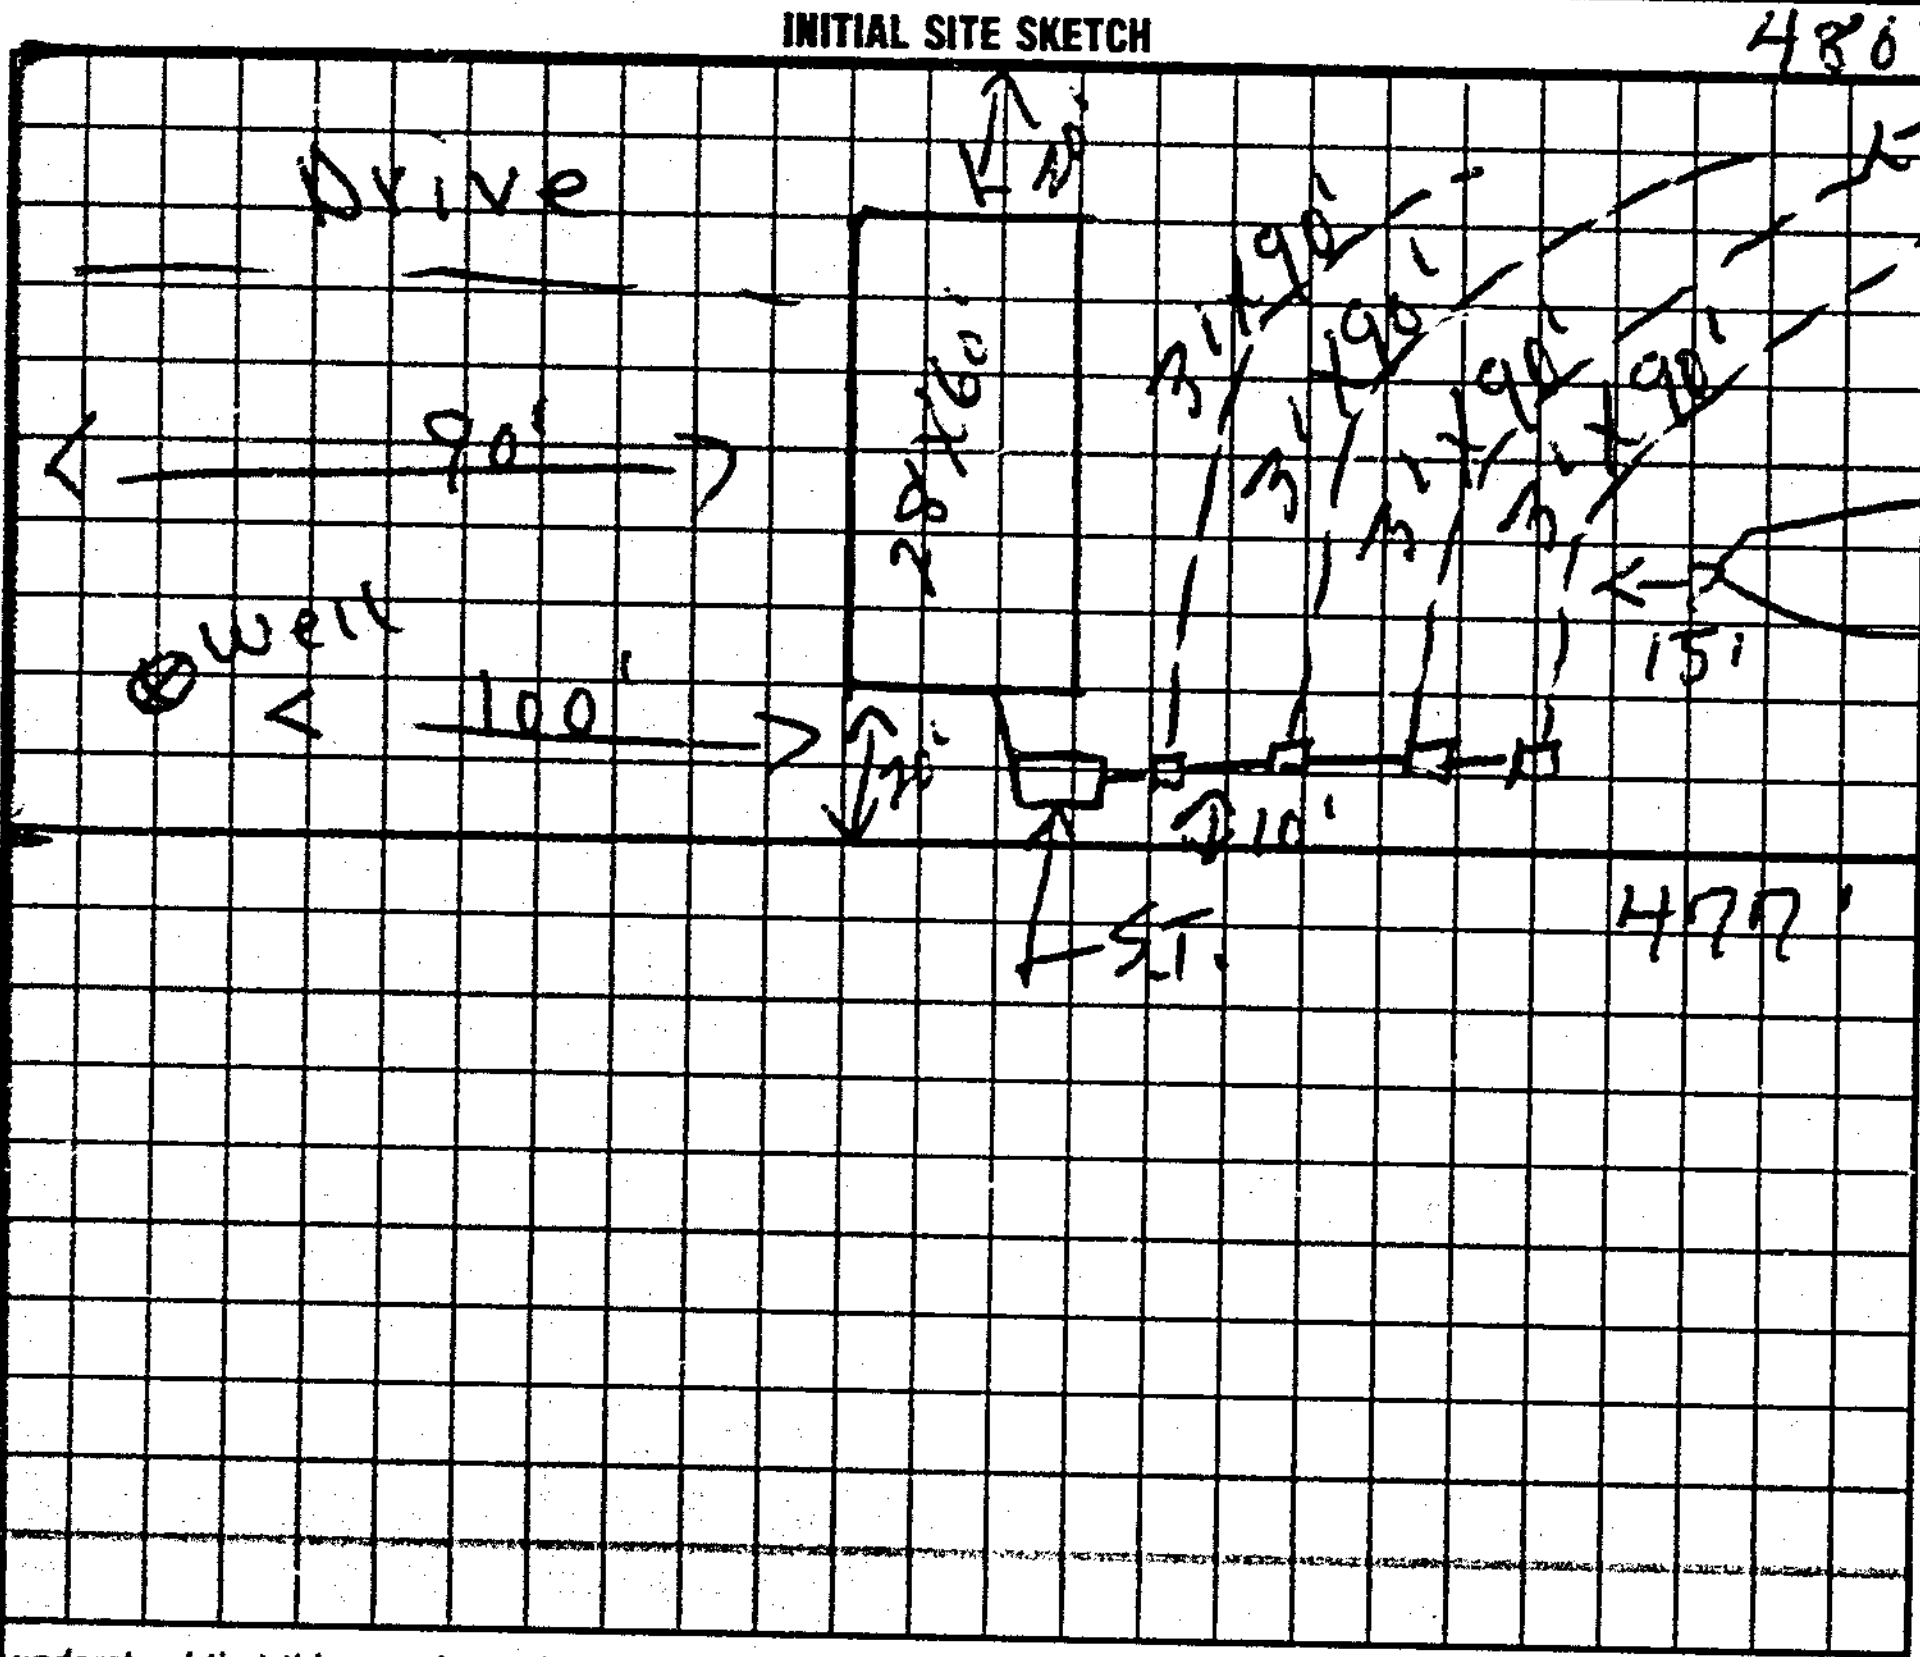

AS BUILT SKETCH

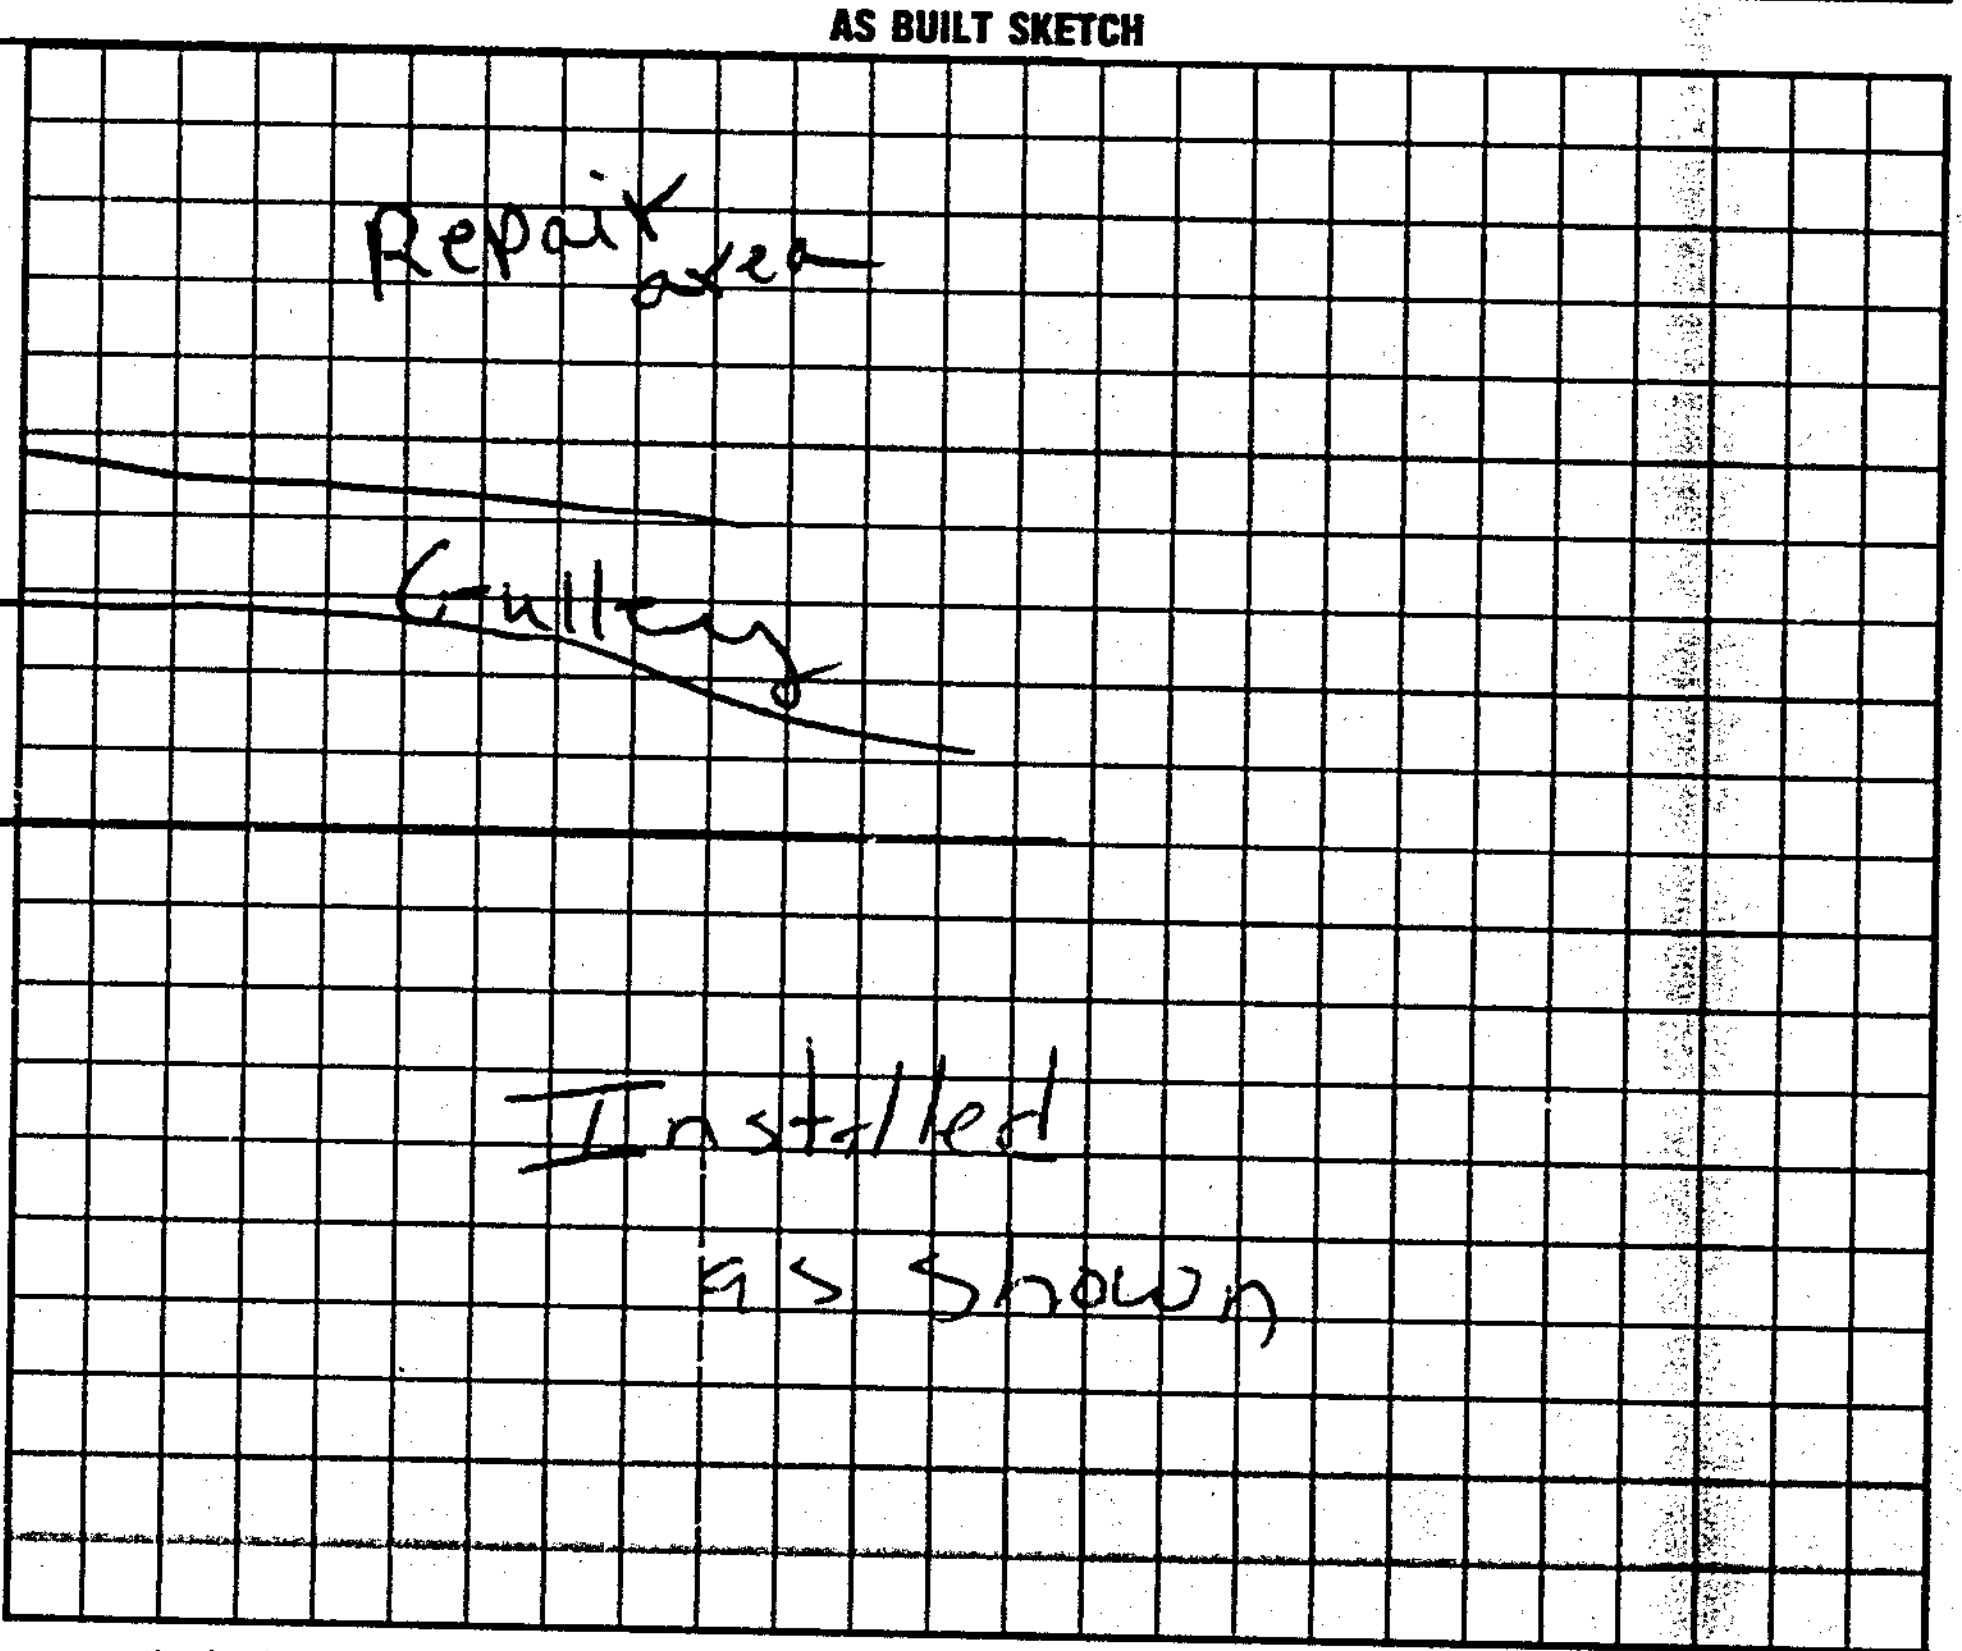

I understand that this permit can be suspended or revoked if any false information is supplied toward securing the permit/any unauthorized changes are made to the site/any unauthorized changes are made in the installation of the system. Improvement Permit is valid for 60 months from date of issuance.

Signed: Rodney L. Braybill

Installed by: A-1 Backhoe

Improvement Permit by: R. C. Moore date 4-24-97

Certificate of Completion by: ______ date ______

Authorization to const
Existing System Inspection by: R. C. Moore date 4-24-97

Operation Permit by: Mark C. [illegible] RS date 2-9-98

HEALTH DEPT. COPY: WHITE INSPECTION COPY (FINAL): GREEN OWNER COPY (FINAL): YELLOW INSPECTION COPY (INITIAL): PINK OWNER COPY (INITIAL): GOLD

Authorization to const Expires 60 mos from issue.