62101

IREDELL COUNTY HEALTH DEPARTMENT

STATESVILLE 704-878-5305 MOORESVILLE 704-664-5281

IMPROVEMENT PERMIT / CERTIFICATE OF COMPLETION / OPERATION PERMIT / EXISTING SYSTEM INSPECTION

PROPERTY DESCRIPTION NO. 24192 DATE 7/20/96 TAX MAP NO. 12A-1-A-12 Watershed: ☐ Yes ☐ No

OWNER OR CONTRACTOR Robin Boggs PHONE: Business 910-961-0911 Home

ADDRESS 1945 Summerfield Road, Statesville NC 28625

LOCATION 6.4 E. LF on Cool Springs, Rt on Cooden Valley ≈ ¼ mile before Battle Rd on Rt

SUBDIVISION Saddlebrook LC BLOCK / SECTION J2 LOT 12 LOT AREA 1.2 acres SITE CLASS. PS DESIGN FLOW 360 L.T.A.R. .33 sq/ft

Septic Tank: 1000 Gallons; STB 1794 Date 2-8-96
Pump Tank: ____ Gallons; PT ____ Date ____
Pump Make: ____ Model ____ Serial No. ____
Nitrification Field: No Fields 1 Square Feet ____ Linear Feet 360
No Lines 4 Trench Width 36" Max Trench Bottom Depth 36" Gravel Depth 12"

☑ New System ☐ Repair System Type: I, II, III, IV, V, VI
System Description: Conventional Capacity
Repair System Description: Conventional Capacity
Maintenance Agreement Required: ☐ Yes ☑ No


☐ House/Mod. Home No. Bedrooms 3
☑ Mobile Home No. Bathrooms 2
☐ Business No. Employees ____
☐ Other ____
☐ Slab ☐ Crawl Space ☐ Basement w/plumbing ☐ Basement wo/plumbing

Water Supply:
☑ Individual
☐ Community
☐ Public
To Be Drilled


Comments: Keep MH 15' From Side Line as far Uphill as possible. Keep Well 100' from system area

Comments: Well Not on Site at Time of this inspection Keep 100' from S.T. System

INITIAL SITE SKETCH

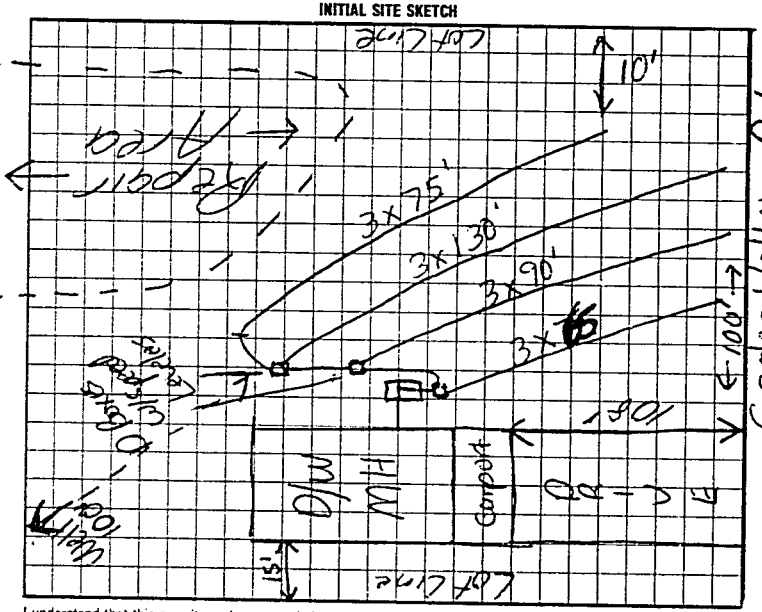

AS BUILT SKETCH

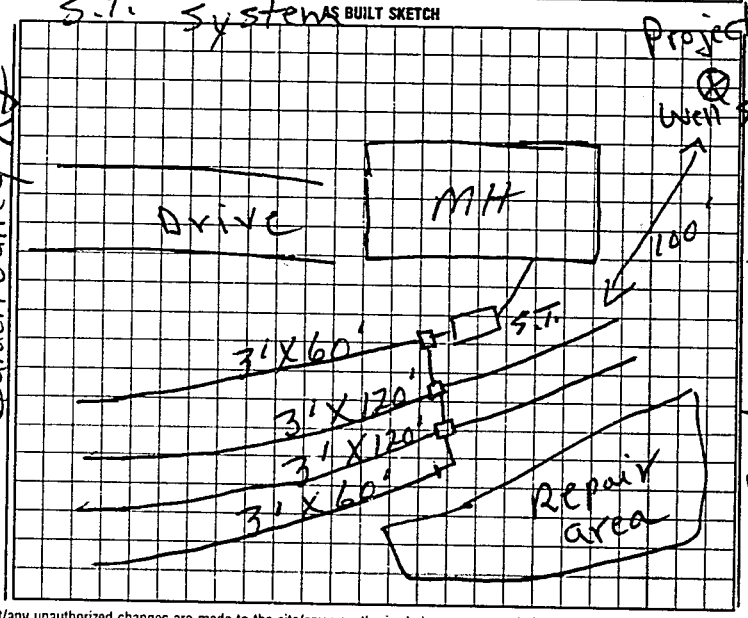

I understand that this permit can be suspended or revoked if any false information is supplied toward securing the permit/any unauthorized changes are made to the site/any unauthorized changes are made in the installation of the system.

Signed: Robin C. Boggs

Improvement Permit by: ____ date 7/20/96

Existing System Inspection by: ____ date 7/20/96

Authorization Void If Construction Not Started Within 5 years

Installed by: A-1 Backhoe

Certificate of Completion by: ____ date ____

Operation Permit by: R. C. Moore date 8-22-96

OWNER COPY (FINAL): YELLOW INSPECTION COPY (INITIAL): PINK OWNER COPY (INITIAL): GOLD