IREDELL COUNTY HEALTH DEPARTMENT

Statesville Office (704) 878-5305 Mooresville Office (704) 660-3625 PERMIT # 178695

IMPROVEMENT PERMIT / AUTHORIZATION TO CONSTRUCT / OPERATION PERMIT / EXISTING SYSTEM

PIN # 4797186772

APPLICANT: Delisa Hicks APPLICANT ADDRESS: 683 Garden Valley Rd.

SITE ADDRESS: 683 Garden Valley Rd. PHONE: 704-929-8299 ALT. PHONE: N/A

SITE DIRECTIONS: Hwy 64 E TL Battle Rd. TL Garden Valley Rd. House on right.


SUBDIVISION: N/A SECTION: N/A LOT # N/A LOT AREA: 9.64 acres DESIGN FLOW: 360gpd L.T.A.R.: Existing

Septic Tank Existing	(gal)	STB	Date	☐ New System ☐ Repair ☐ Expansion	System Type: I (II) III IV V VI	☑ Residence	No. Bedrooms 3	Water Supply
Pump Tank	(gal)	PT	Date	System Description: Conventional		☐ Business	No. Persons	☑ Private
Pump Make	Model		Serial #	Repair System Description:		☐ Other	No. Employees	☐ Public
# Nitrification Fields 1	# Lines Gx		Linear Ft: Gx	Maintenance Agreement Required:	☐ YES ☑ NO	☐ Slab	☑ Crawl Space	☐ Community
Trench Width Gx	Max. Trench Bottom Depth Gx		Gravel Depth Gx		☑ GRAVITY ☐ PRESSURE	☐ Basement w/plumbing	☐ Basement w/o plumbing	


Comments / Conditions:

Maintain a minimum of 5' between the home foundation and all components of septic tank system.

INITIAL SITE SKETCH

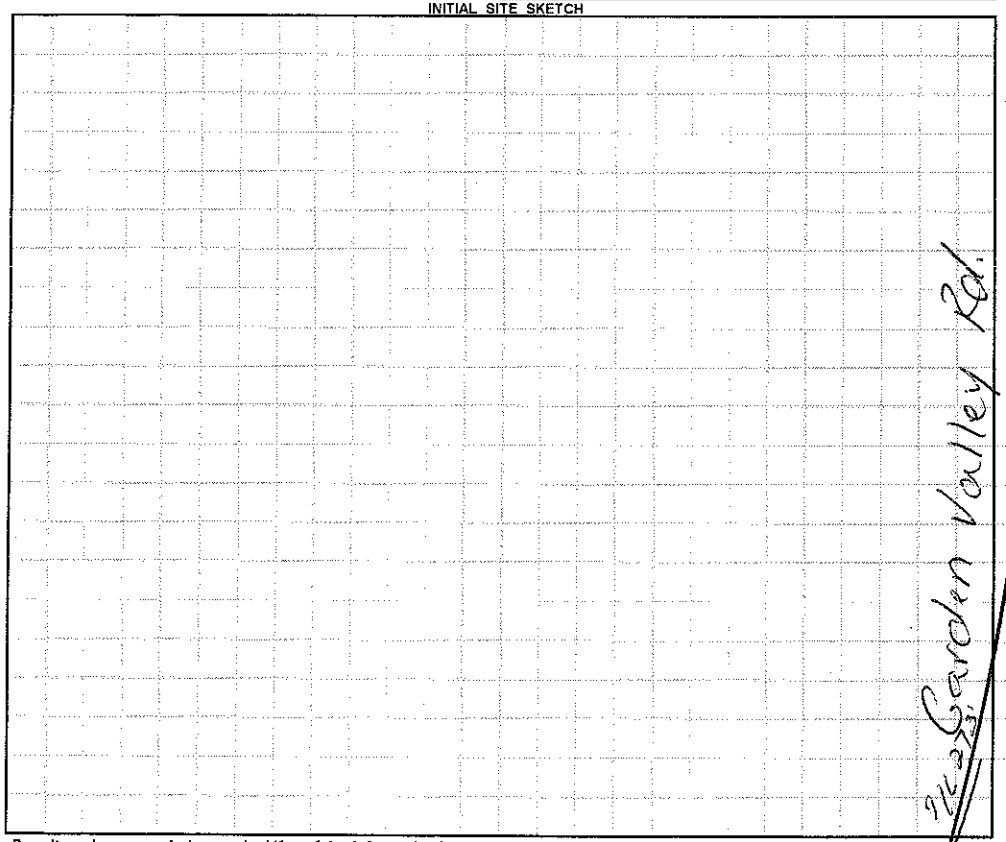

AS BUILT SKETCH

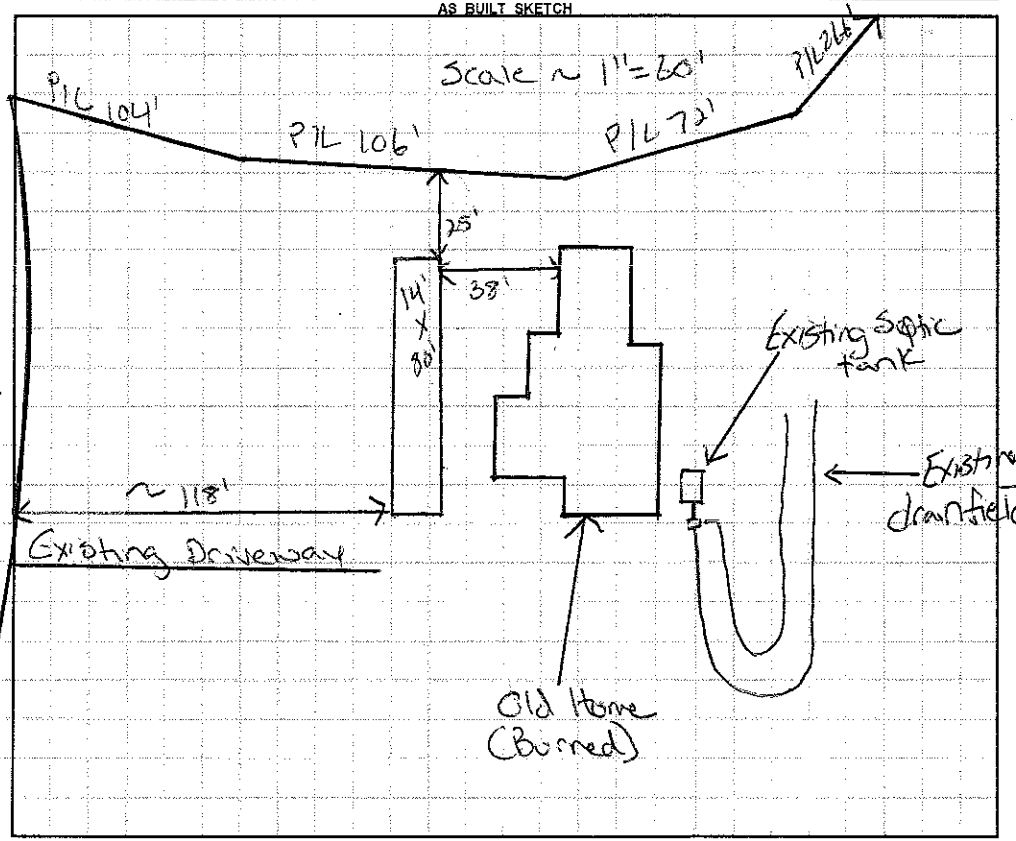

Permit can be suspended or revoked if any false information is supplied toward securing the permit / any unauthorized changes are made to the site / any unauthorized changes are made in the installation of the system. **CONTACT A LOCATOR SERVICE PRIOR TO ANY EXCAVATION**

☐ **IMPROVEMENT PERMIT** *with plat valid without expiration.* ☐ **IMPROVEMENT PERMIT** *with site plan valid for 60 mos.* ☐ **AUTHORIZATION TO CONSTRUCT** *valid for period equal to IMPROVEMENT PERMIT--not to exceed 60 mo.*

Owner / Applicant Signature: Delisa D. Hicks Date: 5-17-13 Installed by:

IMPROVEMENT PERMIT by: Date: OPERATION PERMIT by: Date:

AUTHORIZATION TO CONSTRUCT by: Date: Existing System Inspected by: Justin Mendenhall Date: 5-16-13

Health Dept. Copy - WHITE Applicant (Final Approval) - YELLOW Applicant (Conditional Approval) - PINK