IREDELL COUNTY HEALTH DEPARTMENT

STATESVILLE 704-878-5305 MOORESVILLE 704-664-5281

IMPROVEMENT PERMIT / CERTIFICATE OF COMPLETION / OPERATION PERMIT / EXISTING SYSTEM INSPECTION

PROPERTY DESCRIPTION NO. 63412 DATE 8-18-97 TAX MAP NO. 4797 28 1034 Watershed: ☒ Yes ☐ No

OWNER OR CONTRACTOR Rodney Braxhill PHONE: Business Home 528-9593 ~~WSIV~~ PA

ADDRESS 241 Tricentennial Shoals Statesville

LOCATION 64E TL Battle Rd TL Gartner Valley 1/4 mi on left

SUBDIVISION Saddlebrook BLOCK / SECTION LOT 4 LOT AREA 1.0 acres SITE CLASS. PS DESIGN FLOW 360 L.T.A.R. .33

Septic Tank: 1000 Gallons; STB 1012 Date 5-8-97

Pump Tank: Gallons; PT Date

Pump Make: Model Serial No.

Nitrification Field: No Fields 1 Square Feet 1080 Linear Feet 360

No Lines 4 Trench Width 36" Max Trench Bottom Depth 36" Gravel Depth 12"

☐ New System ☐ Repair System Type: I, II, III, IV, V, VI

System Description: Conv. Gravity

Repair System Description: Gravity Chamber

Maintenance Agreement Required: ☐ Yes ☐ No

☐ House/Mod. Home No. Bedrooms 3

☐ Mobile Home No. Bathrooms 2

☐ Business No. Employees

☐ Other

☐ Slab ☐ Crawl Space ☐ Basement w/plumbing ☐ Basement wo/plumbing


Water Supply: ☐ Individual ☐ Community ☐ Public

Comments:


Comments:

Well & mobile Home Not on Site at Time of this inspection Locate as shown on sketch

INITIAL SITE SKETCH

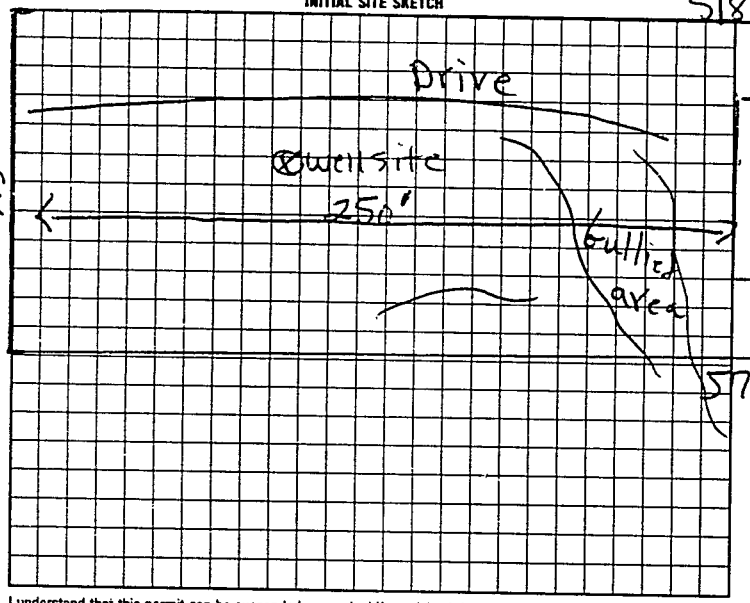

AS BUILT SKETCH

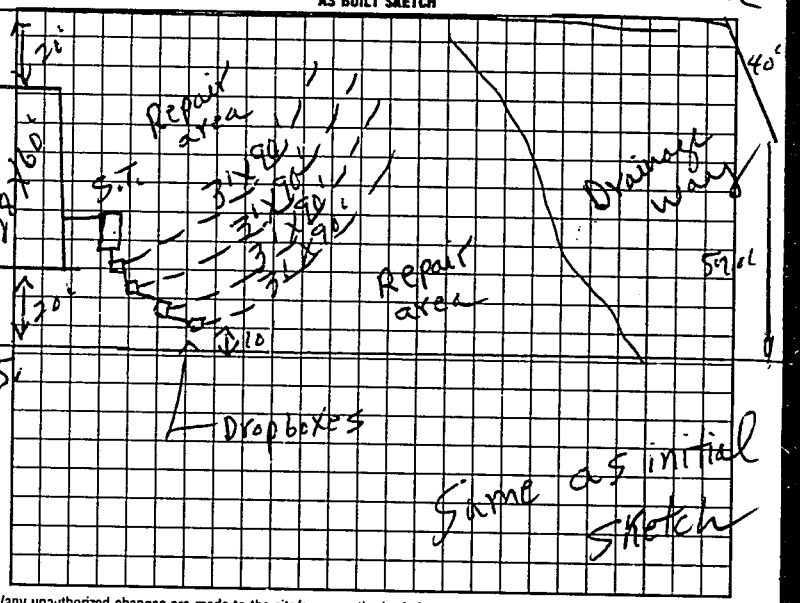

I understand that this permit can be suspended or revoked if any false information is supplied toward securing the permit/any unauthorized changes are made to the site/any unauthorized changes are made in the installation of the system. Improvement Permit is valid for 60 months from date of issuance.

Signed: Rodney Braxhill

Improvement Permit by: P. C. Moore date 8-18-97

Authorization to Construct by: P. C. Moore date 8-18-97

Existing System Inspection by:

Installed by: A-1 Backhoe

Certificate of Completion by: date

Operation Permit by: P. C. Moore date 9-22-97

HEALTH DEPT. COPY WHITE INSPECTION COPY (FINAL) GREEN OWNER COPY (FINAL) YELLOW INSPECTION COPY (INITIAL) PINK OWNER COPY (INITIAL) GOLD

Authorization to Construct. Expires 60 mos from issue