IREDELL COUNTY HEALTH DEPARTMENT

STATESVILLE 704-878-5305 MOORESVILLE 704-664-5281

IMPROVEMENT PERMIT / AUTHORIZATION TO CONSTRUCT / OPERATION PERMIT / EXISTING SYSTEM INSPECTION

PERMIT# 101695 PIN# 4797-28-3117 DATE 8-25-01

OWNER OR CONTRACTOR ROBERT L. BYRD PHONE: Business _____ Home (704) 546-3471

ADDRESS 709 GARDEN VALLEY ROAD, HARMONY NC 28634

LOCATION I-40 EAST TL US 64 AT COUNTY LINE, TL BATTLE ROAD, TL GARDEN VALLEY RD, MH on LEFT at #709

SUBDIVISION SADDLEBROOK BLOCK / SECTION _____ LOT 2 LOT AREA 0.93 ACRE SITE CLASS PS DESIGN FLOW 360 L.T.A.R. 0.40 GPD/FT²

Septic Tank: 1000 Gallons: STB 760 Date 5-21-01
Pump Tank: _____ Gallons: PT _____ Date _____
Pump Make: _____ Model _____ Serial No _____
Nitrification Field: No Fields 1 Square Feet 900 Linear Feet 300
No Lines SIX Trench Width 36" Max Trench Bottom Depth 36" Gravel Depth 12"

✓ New System ☐ Repair System Type: I II III IV V VI
System Description: CONVENTIONAL GRAVITY
Repair System Description: CONV. GRAVITY
Maintenance Agreement Required: ☐ Yes ✓ No
☐ Slab ☐ Crawl Space ☐ Basement w/plumbing ☐ Basement wo/plumbing


✓ House/Mod. Home No. Bedrooms 3
✓ Mobile Home No. Bathrooms 2
☐ Business No. Employees _____
☐ Other _____

Water Supply:
✓ Individual
☐ Public
☐ Community
WELL NEW DOOR

Comments/Conditions:

Comments/Conditions SEPTIC TANK WITH MARKER INSTALLED USING "ZABEL" FILTER

INITIAL SITE SKETCH

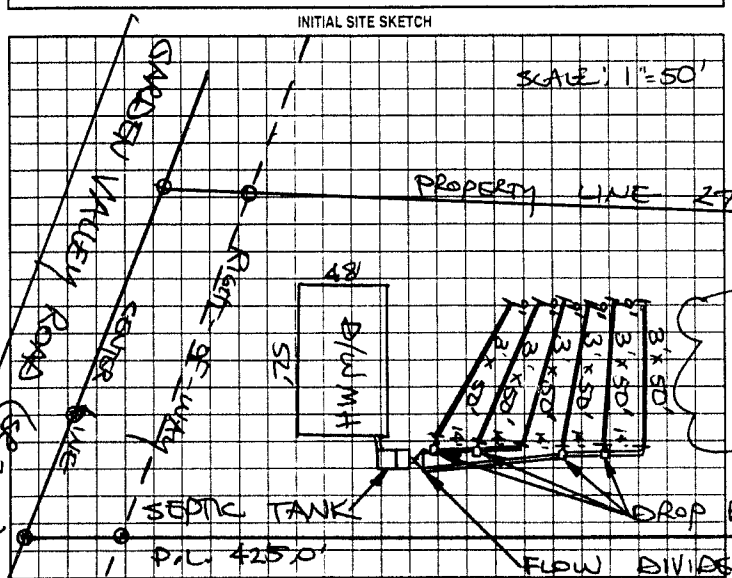

AS BUILT SKETCH

SYSTEM INSTALLED ACCORDING TO INITIAL SITE SKETCH

Permit can be suspended or revoked if any false information is supplied toward securing the permit/any unauthorized changes are made to the site/any unauthorized changes are made in the installation of the system. Improvement Permit with plat valid without expiration. Improvement Permit with site plan valid for sixty months. Authorization to Construct is valid for a period equal to that of Improvement Permit - not to exceed sixty months.

Signed: Robert Byrd date 8.25.01 Installed by: STEVE BRYANT

Improvement Permit by: STEVE HEDRICK date 8-25-01 Operation Permit by: STEVE HEDRICK date 9-6-01

Authorization to Construct by: STEVE HEDRICK date 8-25-01 Existing System Inspection by: _____ date _____

HEALTH DEPT COPY WHITE OWNER COPY (FINAL) YELLOW OWNER COPY (INITIAL) PINK