IREDELL COUNTY HEALTH DEPARTMENT

Statesville Phone TR 3-7271 Mooresville Phone NO 3-1271

PERMIT TO INSTALL SEPTIC TANK

Permit No. 108 Permit Date 12-19 1972

Owner Brown Porter-Carpet Outlet Address Statesville, NC

Installed By Davie Septic Tank Co. Address Rt 4 Mocksville, NC


Location of Property 64 E near Davie County Line at Intersection I-40

Tank		Capacity		Length of Lines		Fixtures	
Block	( )	1000	(✓)	225'	(✓)	No. of Baths	(2)
Precast	(✓)	1250	( )	250'	( )	Dishwasher	( )
		1500	( )	Other		Garbage Grdr.	( )
		Other				Other	

NOTIFY HEALTH DEPARTMENT AT LEAST EIGHT HOURS BEFORE TANK IS TO BE INSPECTED.

Final Inspection 12-19 1972 Approved (✓) Disapproved ( )

Remarks Water Supply 300' from System -

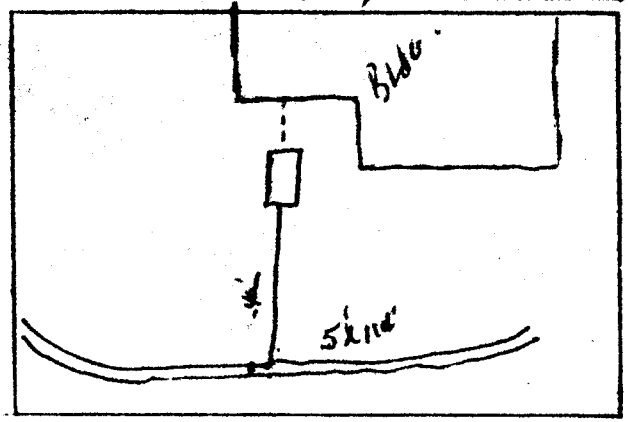

Sketch of Installation

Glenn L. D...

Sanitarian