THIS PERMIT VOIDS PREVIOUS ISSUED 12-5-2000

IREDELL COUNTY HEALTH DEPARTMENT

STATESVILLE 704-878-5305 (21) MOORESVILLE 704-664-5281

IMPROVEMENT PERMIT / AUTHORIZATION TO CONSTRUCT / OPERATION PERMIT / EXISTING SYSTEM INSPECTION

PERMIT# 093160 PIN# 4797 37 4037 (PART) DATE 4-11-01

OWNER OR CONTRACTOR CHUCK BENNETT PHONE: Business Home (704) 546-3199

ADDRESS 142 GUILFORD RD HARMONY NC 28634

LOCATION US 64 EAST TL BATTLE RD, MIDDLE LOT ON RIGHT PAST CURVE

SUBDIVISION JAMES SHEEK BLOCK / SECTION LOT LOT AREA 1.030 ACRE SITE CLASS PS DESIGN FLOW 360 L.T.A.R. 0.30 GPD/FT²

Septic Tank: 1000 Gallons: STB 794 Date 9-18-02
Pump Tank: Gallons: PT Date
Pump Make: Model Serial No
Nitrification Field: No Fields 1 Square Feet EQ. TO 1200 Linear Feet 200
No Lines SIX Trench Width 24" Max Trench Bottom Depth 36" Gravel Depth SAND 6"

☑ New System ☐ Repair System Type I II III IV V VI
System Description: 50% REDUCTION GRAVITY
Repair System Description: 50% REDUCTION LAY PERS.
Maintenance Agreement Required: Yes ☑ No

☐ House/Mod. Home No. Bedrooms 3
☑ Mobile Home No. Bathrooms 2
☐ Business No. Employees
☐ Other


Water Supply: ☑ Individual ☐ Public ☐ Community
WELL

☐ Slope ☑ Crawl Space ☐ Basement w/plumbing ☐ Basement wo/plumbing


Comments/Conditions: ① INSTALL 50% REDUCTION SYSTEM USING FORTY-EIGHT (48) PPBPS PANELS ② KEEP SYSTEM MINIMUM 100 FEET FROM WELL (.1956(6)(9))

Comments/Conditions: SEPTIC TANK WITH MARKER IN STALLED USING "ZABEL" FILTER

INITIAL SITE SKETCH

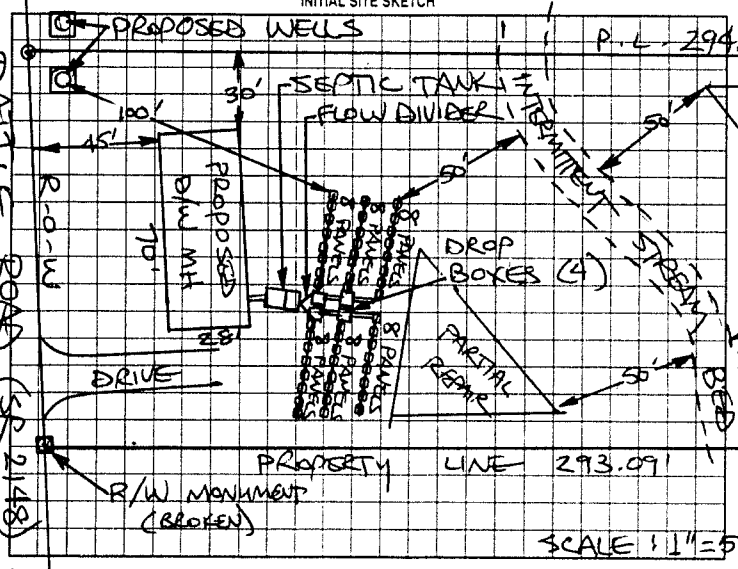

AS BUILT SKETCH

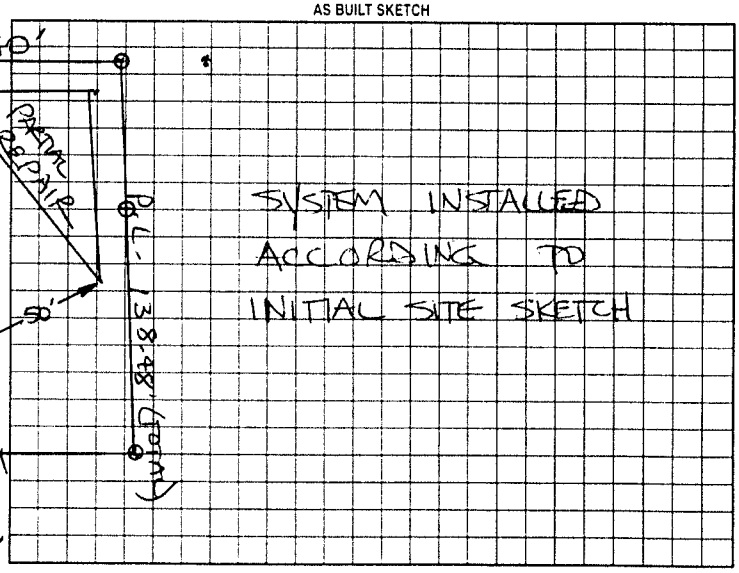

Permit can be suspended or revoked if any false information is supplied toward securing the permit; any unauthorized changes are made to the site; any unauthorized changes are made in the installation of the system. Improvement Permit with plat valid without expiration. Improvement Permit with site plan valid for sixty months. Authorization to Construct is valid for a period equal to that of Improvement Permit – not to exceed sixty months.

Signed: Charlie E. Bennett date 4-11-01 Installed by: BUDDY CHANEY

Improvement Permit by: STEVE HEDRICK date 4-11-01 Operation Permit by: STEVE HEDRICK date 12-17-02

Authorization to Construct by: STEVE HEDRICK date 4-11-01 Existing System Inspection by: date

HEALTH DEPT COPY WHITE OWNER COPY (FINAL) YELLOW OWNER COPY (INITIAL) PINK