pd $50 12-8-00

IREDELL COUNTY HEALTH DEPARTMENT

STATESVILLE 704-878-5305 MOORESVILLE 704-664-5281

IMPROVEMENT PERMIT / AUTHORIZATION TO CONSTRUCT / OPERATION PERMIT / EXISTING SYSTEM INSPECTION

DATE Dec. 7 00

PERMIT# 089138 PIN# 4797387379

OWNER OR CONTRACTOR Dennis Limberg PHONE: Business 872-3621 Home

ADDRESS 335 Newport DR. Salisbury NC 28144

LOCATION US 64 East just past County Line sign on left ~350'± off Road

SUBDIVISION BLOCK / SECTION LOT LOT AREA ~2 acres SITE CLASS IS DESIGN FLOW 360gpd L.T.A.R. .3±

Septic Tank: 1000 Gallons; STB 1012 Date 8-31-00

Pump Tank: Gallons; PT Date

Pump Make: Model Serial No

Nitrification Field: No Fields 1 Square Feet 1200 Linear Feet 400

No Lines 4@100 Trench Width 36" Max Trench Bottom Depth 36" Gravel Depth 12"

☑ New System ☐ Repair System Type: I. II. III. IV. V. VI

System Description: GRAVITY CONVENTIONAL

Repair System Description: CONV OR INNOVATIVE

Maintenance Agreement Required: ☐ Yes ☑ No

☐ Slab ☐ Crawl Space ☐ Basement w/plumbing ☑ Basement wo/plumbing

☐ House/Mod Home No. Bedrooms 3

☐ Mobile Home No. Bathrooms 3

☐ Business No. Employees

☐ Other

Water Supply: ☑ Individual ☐ Public ☐ Community


Comments/Conditions:

This permit Replaces permit issued on 5-17-2000

Comments/Conditions:

not to SCALE

INITIAL SITE SKETCH

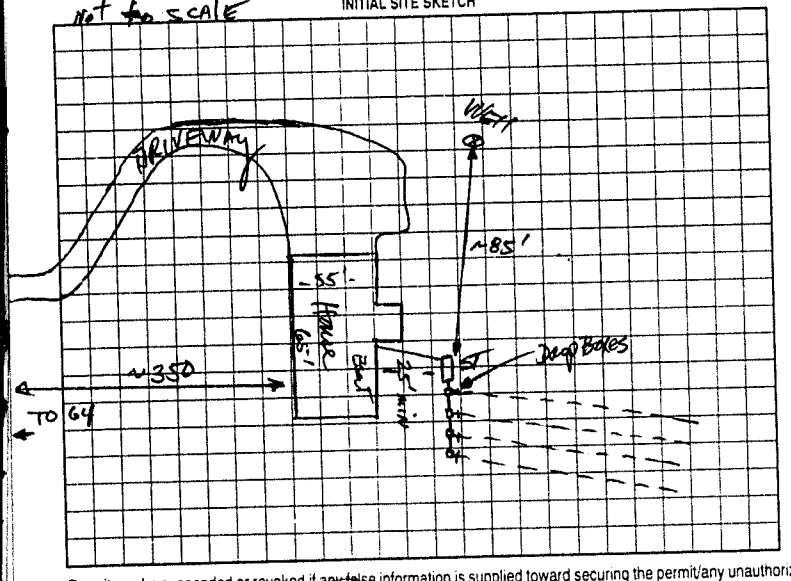

AS BUILT SKETCH

Inst. Nid as shown

Permit can be suspended or revoked if any false information is supplied toward securing the permit/any unauthorized changes are made to the site/any unauthorized changes are made in the installation of the system. Improvement Permit with plat valid without expiration. Improvement Permit with site plan valid for sixty months. Authorization to Construct is valid for a period equal to that of Improvement Permit – not to exceed sixty months.

Signed: date 12/18/00 Installed by: Dale Wagler

Improvement Permit by: date 12-7-00 Operation Permit by: date 1-2-01

Authorization to Construct by: date 12-7-00 Existing System Inspection by: date

HEALTH DEPT. COPY WHITE OWNER COPY (FINAL) YELLOW OWNER COPY (INITIAL) PINK