CI

IREDELL COUNTY HEALTH DEPARTMENT

STATESVILLE 704-878-5305 MOORESVILLE 704-664-5281

IMPROVEMENT PERMIT / AUTHORIZATION TO CONSTRUCT / OPERATION PERMIT / EXISTING SYSTEM INSPECTION

PERMIT# 108113 PIN# 4798-04-9139 DATE 8-27-02

OWNER OR CONTRACTOR FREEDOM HOMES PHONE: Business 704-528-4516 Home

ADDRESS 111 ALLS DRIVE, STATESVILLE, NC 28625

LOCATION OLD MOCKSVILLE ROAD, TR SOCIETY RD, TR SUNFLOWER RD, TL ALLS DR, 2ND LOT ON LEFT

SUBDIVISION SUNFLOWER EST BLOCK / SECTION LOT 9 LOT AREA 1.661 ACRES SITE CLASS. PS DESIGN FLOW 360 L.T.A.R. 0.35 GPD/FT²

Septic Tank: 1000 Gallons: STB 1012 Date 05-25-02
Pump Tank: Gallons: PT Date
Pump Make: Model Serial No.
Nitrification Field: No Fields 1 Square Feet 1035 Linear Feet 345
No Lines SIX Trench Width 36" Max Trench Bottom Depth 36" Gravel Depth 12"

☑ New System ☐ Repair System Type: I (II) III. IV. V. VI
System Description: CONVENTIONAL, GRAVITY
Repair System Description: CONVENTIONAL, GRAVITY
Maintenance Agreement Required: ☐ Yes ☑ No
☐ Slab ☑ Crawl Space ☐ Basement w/plumbing ☐ Basement wo/plumbing


☐ House/Mod Home ☑ Mobile Home ☐ Business ☐ Other
No. Bedrooms 3 No. Bathrooms 2 No. Employees

Water Supply: ☑ Individual ☐ Public ☐ Community
WELL


Comments/Conditions: KEEP SYSTEM MINIMUM 100' FROM WELL

Comments/Conditions SYSTEM INSTALLED AS SHOWN WITH MARKER & TUFF TITE FILTER. WELL & HOME NOT INSTALLED AT TIME OF CHECK.

INITIAL SITE SKETCH

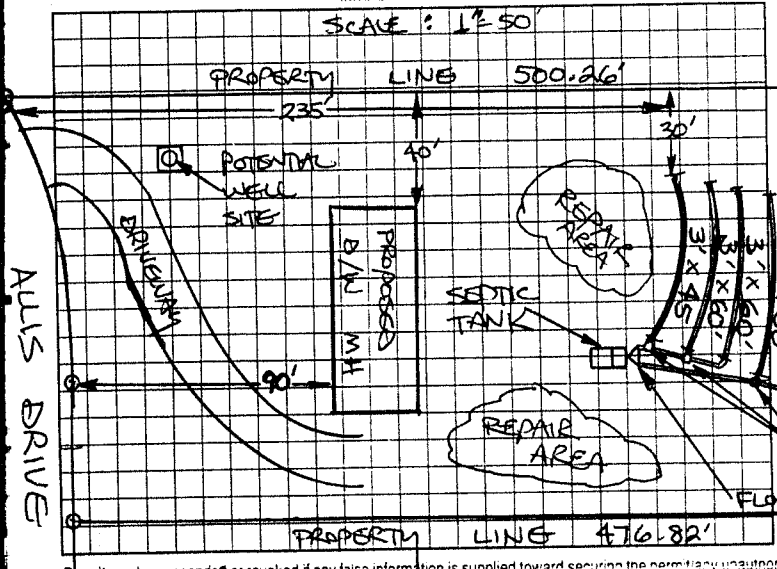

AS BUILT SKETCH

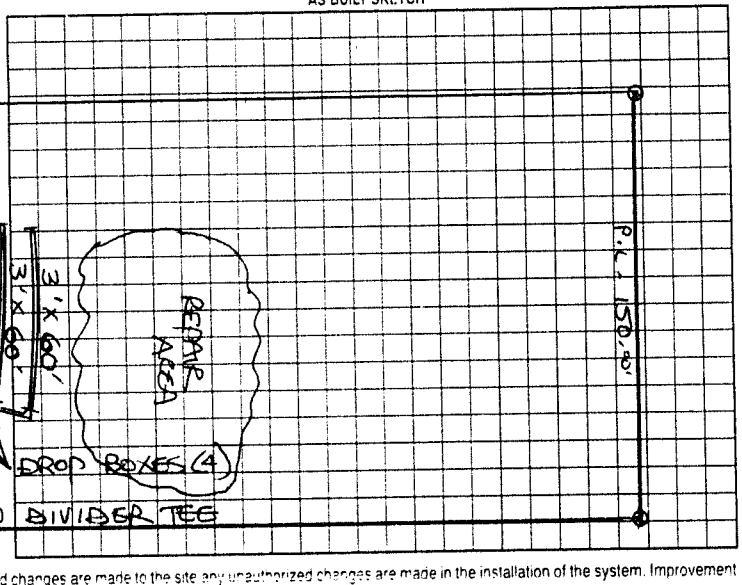

ALLS DRIVE

Permit can be suspended or revoked if any false information is supplied toward securing the permit, any unauthorized changes are made to the site, any unauthorized changes are made in the installation of the system. Improvement Permit with plat valid without expiration. Improvement Permit with site plan valid for sixty months. Authorization to Construct is valid for a period equal to that of Improvement Permit - not to exceed sixty months

Signed: [signature] date 8-29-02 Installed by A-1 BACKHOE

Improvement Permit by: STEVE HEDRICK date 8-27-02 Operation Permit by [signature] ES date 09-03-02

Authorization to Construct by: STEVE HEDRICK date 8-27-02 Existing System Inspection by: date

HEALTH DEPT. COPY: WHITE OWNER COPY (FINAL): YELLOW OWNER COPY (INITIAL): PINK