IREDELL COUNTY HEALTH DEPARTMENT

STATESVILLE 704-878-5305 MOORESVILLE 704-664-5281

IMPROVEMENT PERMIT / AUTHORIZATION TO CONSTRUCT / OPERATION PERMIT / EXISTING SYSTEM INSPECTION

PERMIT# 109370 PIN# 4798-04-9304 DATE 10-23-02

OWNER OR CONTRACTOR Country Living Homes PHONE: Business 704-838-1429 Home

ADDRESS 105 Allis Drive, Statesville NC 28625

LOCATION Old Mocksville Road, TR Society Gk. Rd, TR Sunflower Rd, TL Allis Drive, 1st drive on left

SUBDIVISION Sunflower Est. BLOCK / SECTION 3 LOT 18 LOT AREA 1.948 acres SITE CLASS PS DESIGN FLOW 480 L.T.A.R. 0.40 GPD/FT²

Septic Tank: 1000 Gallons; STB 1012 Date 5-17-02
Pump Tank: Gallons; PT Date
Pump Make: Model Serial No.
Nitrification Field: No Fields 1 Square Feet 1200 Linear Feet 400
No Lines Four Trench Width 36" Max Trench Bottom Depth 36" Gravel Depth 12"

☑ New System ☐ Repair System Type: I, II, III, IV, V, VI
System Description: Conventional gravity
Repair System Description: Conv/25% Red/gravity
Maintenance Agreement Required: ☐ Yes ☑ No

☐ House/Mod. Home No. Bedrooms 4
☑ Mobile Home No. Bathrooms 2
☐ Business No. Employees
☐ Other
☐ Slab ☑ Crawl Space ☐ Basement w/plumbing ☐ Basement wo/plumbing


Water Supply: ☑ Individual ☐ Public ☐ Community
Well

Comments:/Conditions:


Comments:/Conditions: Tuff Tite filter & marker installed as down well & D/W not installed at time of check

INITIAL SITE SKETCH

~ Scale: 1" = 50'

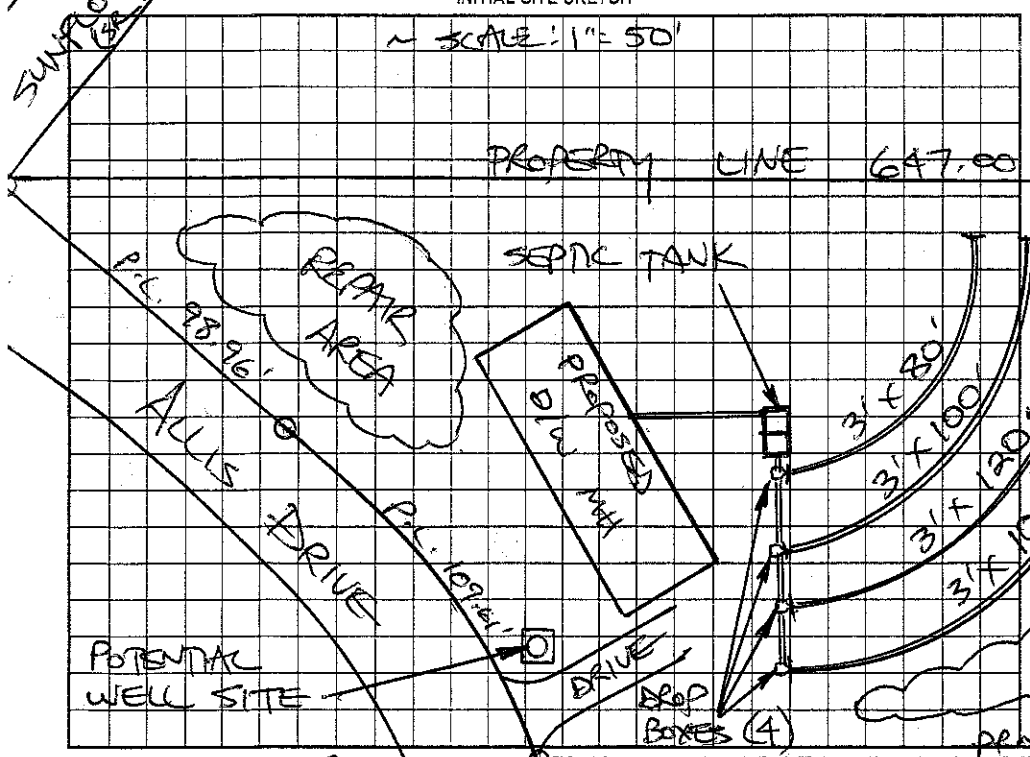

AS BUILT SKETCH

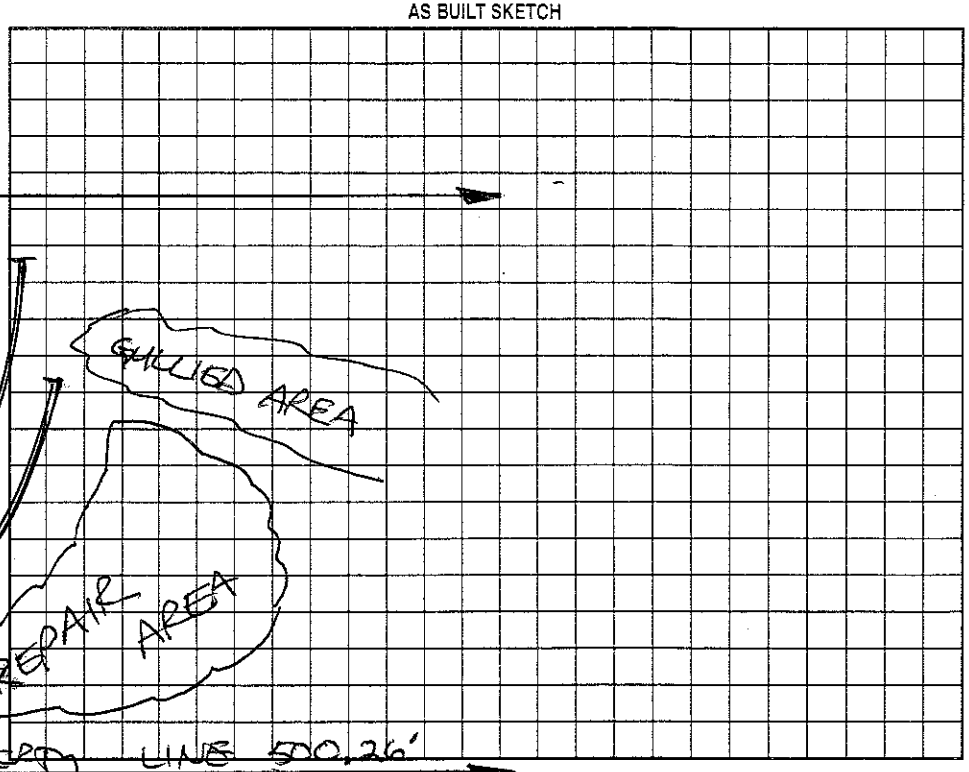

Permit can be suspended or revoked if any false information is supplied toward securing the permit/any unauthorized changes are made to the site/any unauthorized changes are made in the installation of the system. Improvement Permit with plat valid without expiration. Improvement Permit with site plan valid for sixty months. Authorization to Construct is valid for a period equal to that of Improvement Permit – not to exceed sixty months.

Signed: date 10-23-02 Installed by: A-1 Backhoe

Improvement Permit by: Steve Herrick date 10-23-02 Operation Permit by: date 2-12-03

Authorization to Construct by: Steve Herrick date 10-23-02 Existing System Inspection by: date

HEALTH DEPT. COPY: WHITE OWNER COPY (FINAL): YELLOW OWNER COPY (INITIAL): PINK