IREDELL COUNTY HEALTH DEPARTMENT

STATESVILLE 704-878-5305 MOORESVILLE 704-664-5281

IMPROVEMENT PERMIT / AUTHORIZATION TO CONSTRUCT / OPERATION PERMIT / EXISTING SYSTEM INSPECTION

PERMIT# 117541 PIN# 4798-05-~~2649~~ 1759 DATE 1-8-04

OWNER OR CONTRACTOR Fleetwood Homes of Troutman PHONE: Business 704-528-7120 Home

ADDRESS 1040 Charlotte Hwy Troutman, NC 28166

LOCATION US 21 N ® Jane Sawers Rd © Old Mocksville ® Vaughn Mill ® Society Prop is 1st lot on right

SUBDIVISION SOCIETY MANOR BLOCK / SECTION LOT 7 LOT AREA 1.00 SITE CLASS: PS DESIGN FLOW 360 L.T.A.R. .25 gpd/ft²

Septic Tank: 1000 Gallons; STB 1012 Date 8-2-03
Pump Tank: Gallons; PT Date
Pump Make: Model Serial No.
Nitrification Field: No Fields 1 Square Feet 1440 Linear Feet 480
No Lines 6 Trench Width 36" Max Trench Bottom Depth 24" Gravel Depth 12"

☑ New System ☐ Repair System Type: I, II, III, IV, V, VI
System Description: Con Gravity
Repair System Description: Con Gravity
Maintenance Agreement Required: ☐ Yes ☑ No

☐ House/Mod. Home No. Bedrooms 3
☑ Mobile Home No. Bathrooms 2
☐ Business No. Employees
☐ Other


Water Supply: ☐ Individual ☑ Public ☑ Community

☐ Slab ☑ Crawl Space ☐ Basement w/plumbing ☐ Basement wo/plumbing


Comments:/Conditions: ① Install lines 20-24" on contour ② Maintain all setbacks ③ * MUST MEET INSTALLER PRIOR TO START

Comments:/Conditions: ① TUFF-TITE FILTER ② FLOW DIV. LEVEL O/C

INITIAL SITE SKETCH SCALE 1" = 50'

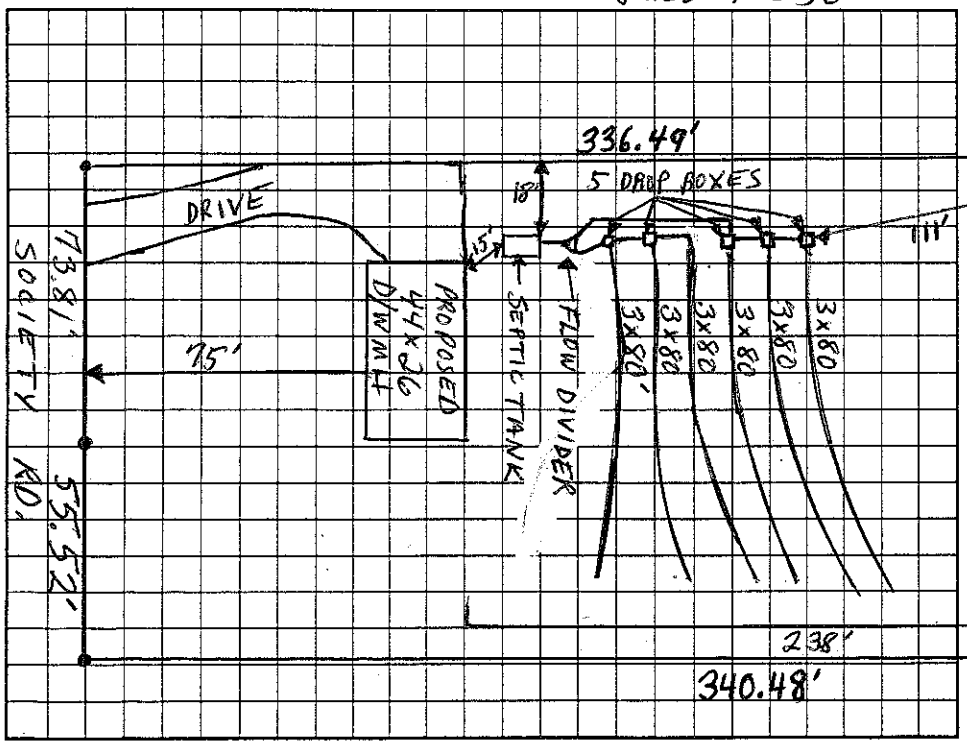

AS BUILT SKETCH

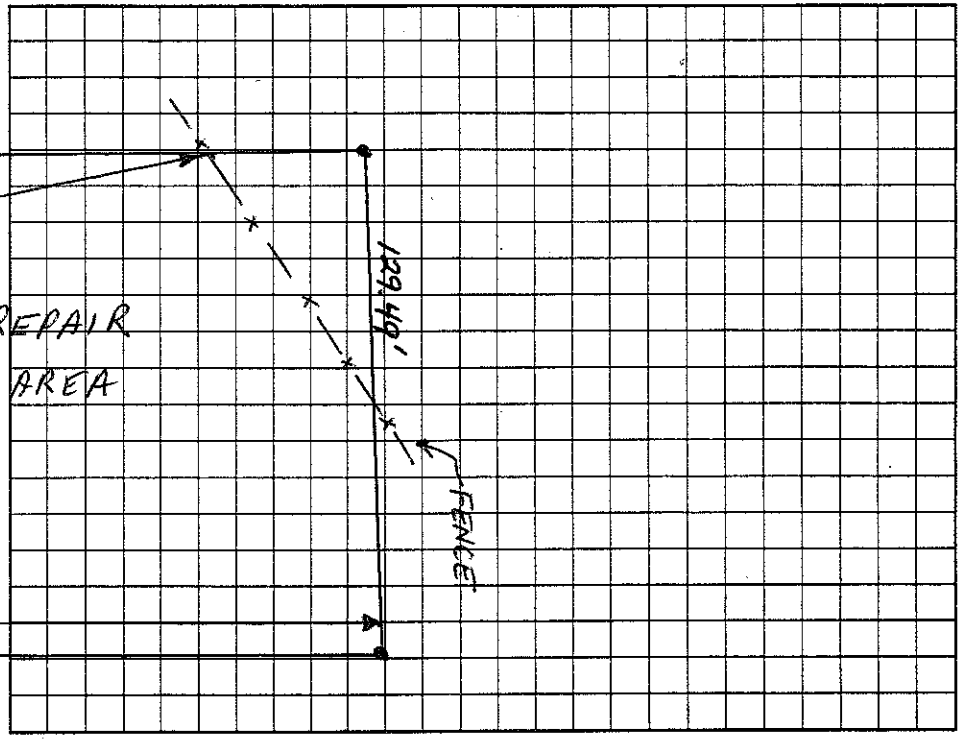

Permit can be suspended or revoked if any false information is supplied toward securing the permit/any unauthorized changes are made to the site/any unauthorized changes are made in the installation of the system. Improvement Permit with plat valid without expiration. Improvement Permit with site plan valid for sixty months. Authorization to Construct is valid for a period equal to that of Improvement Permit – not to exceed sixty months.

Signed: Ed Osborne date 1-9-04

Improvement Permit by: Christopher M. Sherrill R.S. date 1/8/04

Authorization to Construct by: Christopher M. Sherrill, R.S. date 1/8/04

Installed by: Craig Thompson Septic

Operation Permit by: Christopher M. Sherrill, R.S. date 1-22-03

Existing System Inspection by: date

HEALTH DEPT. COPY: WHITE OWNER COPY (FINAL): YELLOW OWNER COPY (INITIAL): PINK