IREDELL COUNTY HEALTH DEPARTMENT

STATESVILLE 704-878-5305 MOORESVILLE 704-664-5281

IMPROVEMENT PERMIT / AUTHORIZATION TO CONSTRUCT / OPERATION PERMIT / EXISTING SYSTEM INSPECTION

PERMIT# 119294 PIN# 4798-05-2647 2618 DATE 3-1-04

~~OWNER~~ OR CONTRACTOR ED OSBORNE PHONE: Business 704-528-7128 Home

ADDRESS 1040 CHARLOTTE Hwy, TROUTMAN, NC 28166

LOCATION OLD MOCKSVILLE ROAD NE, 1 TR SOCIETY ROAD, 2ND DWELLING ON RIGHT PAST VAUGHN MILL ROAD

SUBDIVISION SOCIETY MANOR BLOCK / SECTION ____ LOT 4 LOT AREA 4.39 ACRES SITE CLASS. PS DESIGN FLOW 360 L.T.A.R. EXISTING 0.33 GPD/FT2

Septic Tank: EXISTING Gallons; STB ____ Date ____

Pump Tank: ____ Gallons; PT ____ Date ____

Pump Make: ____ Model ____ Serial No. ____

Nitrification Field: No Fields 1 Square Feet 360 Linear Feet 120

No Lines ONE Trench Width 36" Max Trench Bottom Depth 36" Gravel Depth 12"

☑ New System ☐ Repair System Type: I, (II), III, IV, V, VI

System Description: CONVENTIONAL, GRAVITY

Repair System Description: 25% REDUCTION, GRAVITY

Maintenance Agreement Required: ☐ Yes ☑ No

☐ House/Mod. Home No. Bedrooms 3

☑ Mobile Home No. Bathrooms 2

☐ Business No. Employees ____

☐ Other ____


☐ Slab ☑ Crawl Space ☐ Basement w/plumbing ☐ Basement wo/plumbing

Water Supply: ☐ Individual ☑ Public ☐ Community


Comments:/Conditions: INSTALL NEW 3'X120' LINE ON CONTOUR AS FLAGGED. REPLACE EXISTING DISTRIBUTION BOX IF NECESSARY.

Comments:/Conditions: ① D-BOX REPLACED W/ SPEED LEVELERS

INITIAL SITE SKETCH

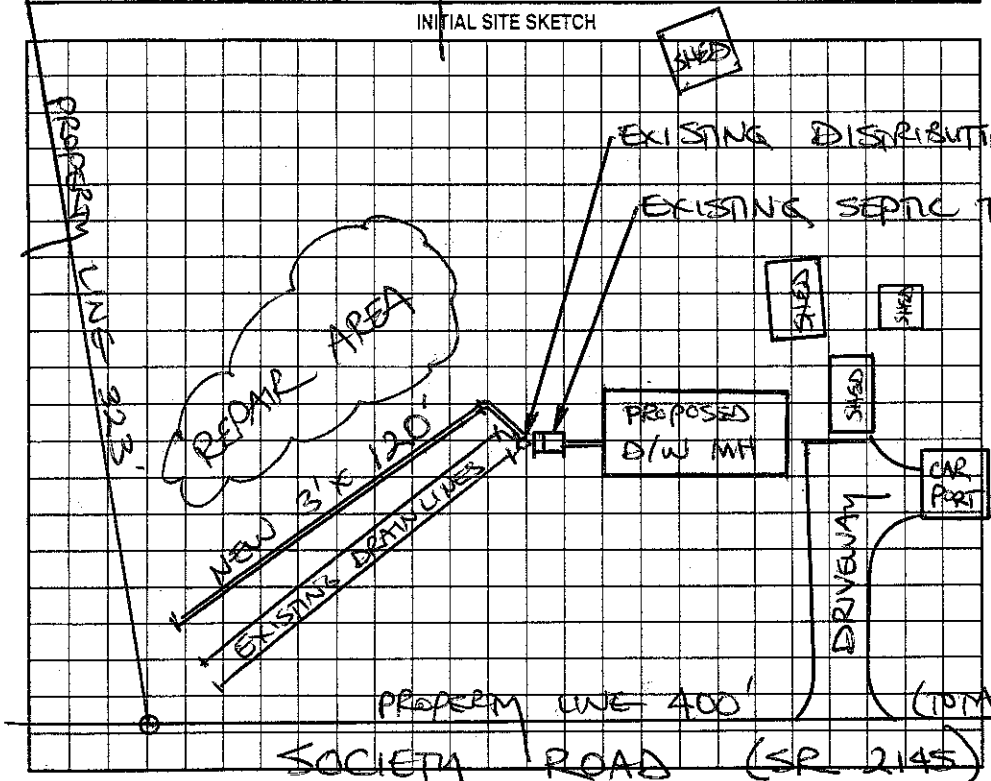

AS BUILT SKETCH

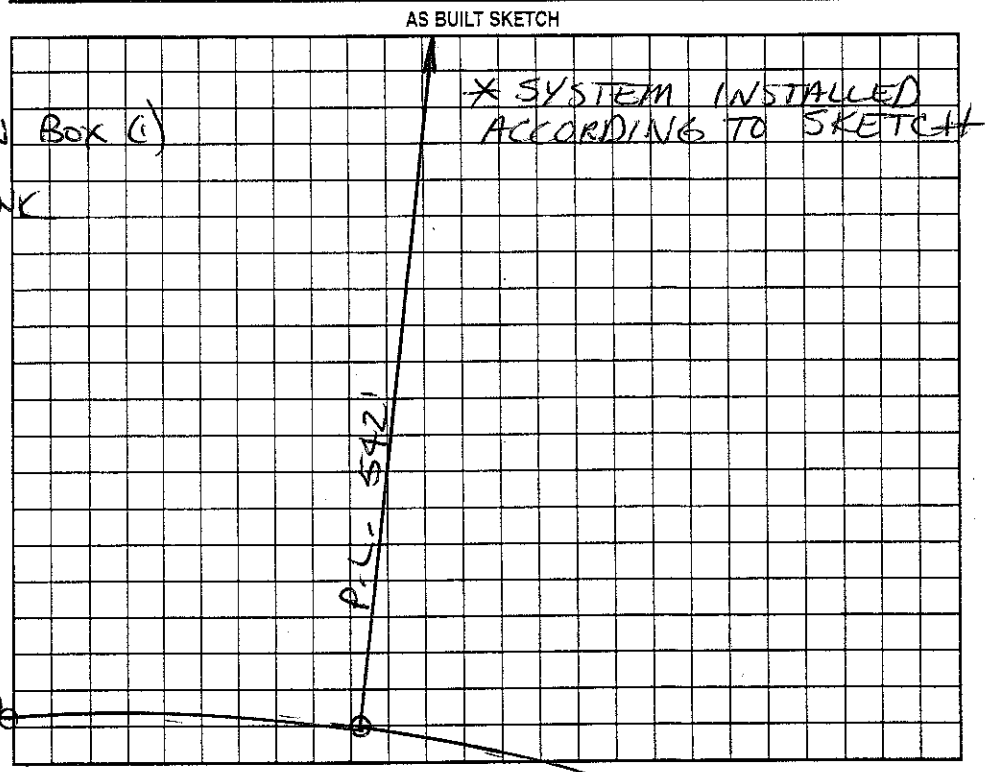

Permit can be suspended or revoked if any false information is supplied toward securing the permit/any unauthorized changes are made to the site/any unauthorized changes are made in the installation of the system. Improvement Permit with plat valid without expiration. Improvement Permit with site plan valid for sixty months. Authorization to Construct is valid for a period equal to that of Improvement Permit – not to exceed sixty months.

Signed: ED Osborne date 3-1-04

Improvement Permit by: STEVE HEDRICK date 3-1-04

Authorization to Construct by: STEVE HEDRICK date 3-1-04

Installed by: Craig Thompson Septic

Operation Permit by: Christopher M. Sherrill, RS date 3-4-04

Existing System Inspection by: ____ date ____

HEALTH DEPT. COPY: WHITE OWNER COPY (FINAL): YELLOW OWNER COPY (INITIAL): PINK