THIS PERMIT VOIDS PREVIOUS ISSUED 10-5-01

IREDELL COUNTY HEALTH DEPARTMENT

STATESVILLE 704-878-5305 (C1) MOORESVILLE 704-664-5281

IMPROVEMENT PERMIT / AUTHORIZATION TO CONSTRUCT / OPERATION PERMIT / EXISTING SYSTEM INSPECTION

(A)

PERMIT# 102378 PIN# 4788-86-9920 DATE 1-2-02

OWNER OR CONTRACTOR ROGER SIMIELE PHONE: Business (315) 363-1708 Home (704) 546-3582

ADDRESS 251 SOCIETY ROAD, STATESVILLE, NC 28625

LOCATION OLD MOCKSVILLE ROAD, TR SOCIETY ROAD, 0.6 MILE ON RIGHT

SUBDIVISION HENRY LEWIS ESTATE BLOCK / SECTION ____ LOT 2 LOT AREA 6.01 ACRES SITE CLASS PS DESIGN FLOW 480 L.T.A.R. 0.25 GPD/FT²

Septic Tank: 1000 Gallons: STB 1012 Date 3-3-02
Pump Tank: ____ Gallons: PT ____ Date ____
Pump Make: ____ Model ____ Serial No. ____
Nitrification Field: No Fields 1 Square Feet 1920 Linear Feet 640
No Lines 8IX Trench Width 36" Max Trench Bottom Depth 36" Gravel Depth 12"

☒ New System ☐ Repair System Type: I, (II), III, IV, V, VI
System Description: CONVENTIONAL GRAVITY
Repair System Description: CONVENTIONAL GRAVITY
Maintenance Agreement Required: ☐ Yes ☒ No


☒ House/Mod. Home No. Bedrooms 4
☐ Mobile Home No. Bathrooms 2 ½
☐ Business No. Employees ____
☐ Other ____
☐ Slab ☒ Crawl Space ☐ Basement w/plumbing ☐ Basement wo/plumbing

Water Supply: ☐ Individual ☒ Public ☐ Community


Comments/Conditions:

Comments/Conditions: SEPTIC TANK WITH MARKER INSTALLED USING "POLY LOK" FILTER

INITIAL SITE SKETCH

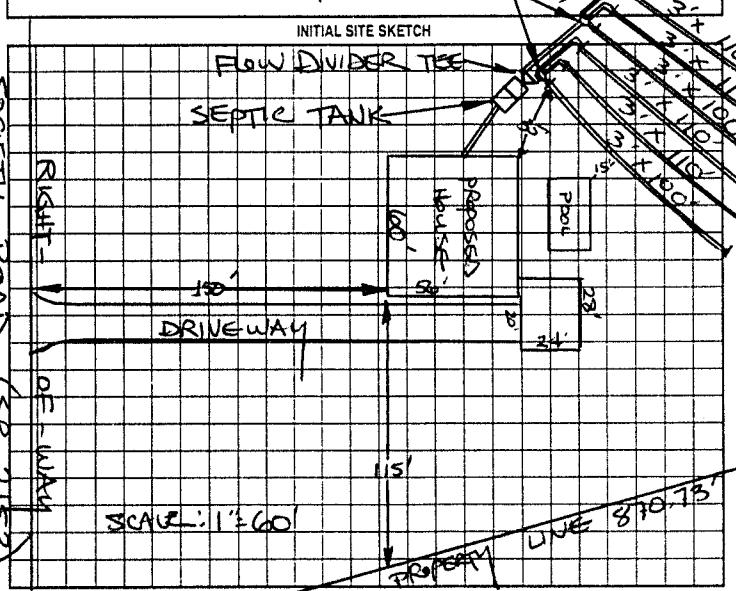

AS BUILT SKETCH

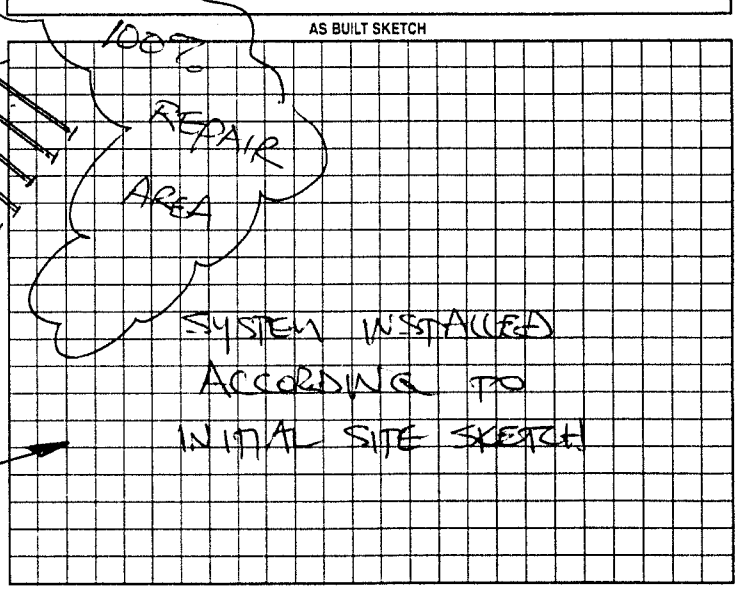

Permit can be suspended or revoked if any false information is supplied toward securing the permit/any unauthorized changes are made to the site/any unauthorized changes are made in the installation of the system. Improvement Permit with plat valid without expiration. Improvement Permit with site plan valid for sixty months. Authorization to Construct is valid for a period equal to that of Improvement Permit – not to exceed sixty months.

Signed: [illegible] Culman date 1-2-02 Installed by: DAVID YOUNTZ

Improvement Permit by: STEVE HEDRICK date 1-2-02 Operation Permit by: STEVE HEDRICK date 4-30-02

Authorization to Construct by: STEVE HEDRICK date 1-2-02 Existing System Inspection by: ____ date ____

HEALTH DEPT. COPY: WHITE OWNER COPY (FINAL): YELLOW OWNER COPY (INITIAL): PINK