THIS PERMIT VOIDS PREVIOUS ISSUED 1-20-00 CI

IREDELL COUNTY HEALTH DEPARTMENT

STATESVILLE 704-878-5305 MOORESVILLE 704-664-5281

IMPROVEMENT PERMIT / AUTHORIZATION TO CONSTRUCT / OPERATION PERMIT / EXISTING SYSTEM INSPECTION

PERMIT# 087290 PIN# 4798 07 5920 (PT) DATE 10-5-00

OWNER OR CONTRACTOR JEFFREY CHUBY PHONE: Business Home 528-0510

ADDRESS 120 GRAYROCK DRIVE, STATESVILLE, NC 28677

LOCATION OLD MOCKSVILLE ROAD, TR SOCIETY RD, LOT ON LEFT ~ 0.5 MILE

SUBDIVISION JAMES C. GAITHER BLOCK / SECTION LOT 1 LOT AREA 5.5 ACRES SITE CLASS PS DESIGN FLOW 360 L.T.A.R. 0.25 GPD/FT²

Septic Tank: 1000 Gallons; STB 1007 Date 9-17-01
Pump Tank: Gallons; PT Date
Pump Make: Model Serial No.
Nitrification Field: No Fields 1 Square Feet 1440 Linear Feet 480
No Lines FOUR Trench Width 36" Max Trench Bottom Depth 36" Gravel Depth 12"

☑ New System ☐ Repair System Type: I (II) III. IV. V. VI
System Description: CONVENTIONAL GRAVITY
Repair System Description: CONV. GRAVITY
Maintenance Agreement Required: ☐ Yes ☑ No


☑ House/Mod. Home No. Bedrooms 3
☐ Mobile Home No. Bathrooms 2½
☐ Business No. Employees
☐ Other
☐ Slab ☑ Crawl Space ☐ Basement w/plumbing ☐ Basement wo/plumbing

Water Supply: ☑ Individual ☐ Public ☐ Community
WELL


Comments/Conditions: ① KEEP SYSTEM MINIMUM 100 FEET FROM WELL, 10 FEET FROM PROPERTY LINE ② USE THREE FLOW DIVIDER TEES TO ACHIEVE EQUAL DISTRIBUTION INTO EACH OF FOUR 3' x 120' DRAIN LINES

Comments/Conditions: SEPERATE HEADER DITCH INSTALLED FOR LAST TWO LINES, INSTALLED AS SHOWN WITH POLYLOK FILTER.

INITIAL SITE SKETCH

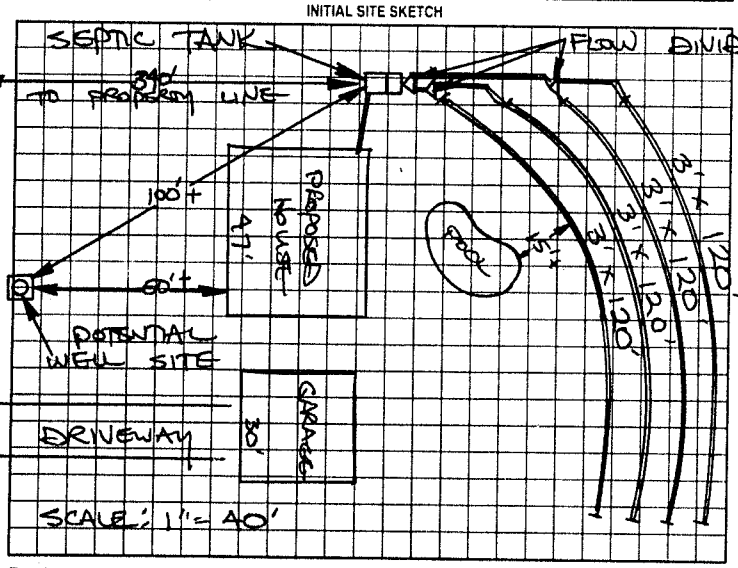

AS BUILT SKETCH

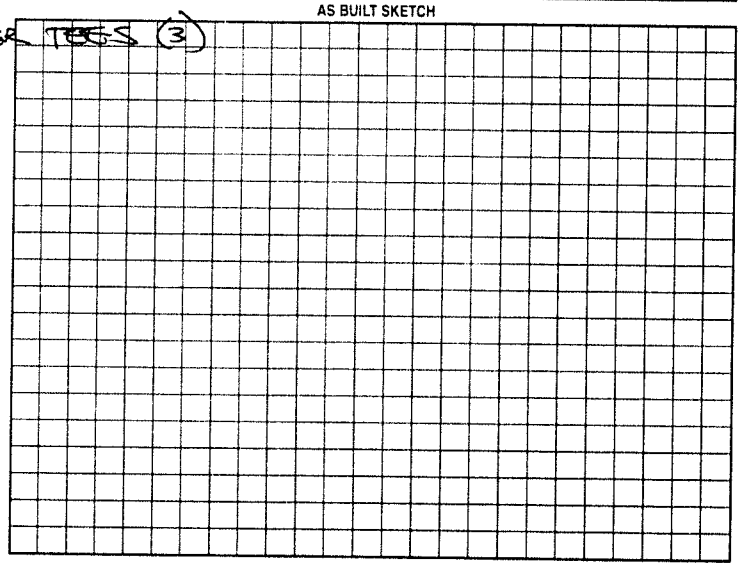

Permit can be suspended or revoked if any false information is supplied toward securing the permit/any unauthorized changes are made to the site/any unauthorized changes are made in the installation of the system. Improvement Permit with plat valid without expiration. Improvement Permit with site plan valid for sixty months. Authorization to Construct is valid for a period equal to that of Improvement Permit – not to exceed sixty months.

Signed: [signature] date 10-5-00 Installed by: JODY TRAVIS ENTERPRISES

Improvement Permit by: STEVE HEDRICK date 10-5-00 Operation Permit by: [signature] date 11-5-01

Authorization to Construct by: STEVE HEDRICK date 10-5-00 Existing System Inspection by: date

HEALTH DEPT. COPY WHITE OWNER COPY (FINAL) YELLOW OWNER COPY (INITIAL) PINK