IREDELL COUNTY HEALTH DEPARTMENT

STATESVILLE 704-878-5305 MOORESVILLE 704-664-5281

IMPROVEMENT PERMIT / AUTHORIZATION TO CONSTRUCT / OPERATION PERMIT / EXISTING SYSTEM INSPECTION

DATE 1-31-00

PERMIT# 87415 PIN# 4798085644

OWNER OR CONTRACTOR Jess Edmonds PHONE: Business Home 704 876 1318

ADDRESS 156 Big Cedar Dr. Statesville, N.C.

LOCATION 64E To Society Ch Rd, 3 miles on Rt.

SUBDIVISION James Gaither property BLOCK / SECTION LOT 6 LOT AREA 5.02 acres SITE CLASS P5 DESIGN FLOW 360 L.T.A.R. .3

Septic Tank: 1000 Gallons; STB 1012 Date 9-16-00

Pump Tank: Gallons; PT Date

Pump Make: Model Serial No

Nitrification Field: No Fields 1 Square Feet 1200 Linear Feet 400

No Lines 3 Trench Width 36" Max Trench Bottom Depth 36" Gravel Depth 12"

☒ New System ☐ Repair System Type: I II III IV V VI

System Description: Conv. Gravity

Repair System Description:

Maintenance Agreement Required: ☐ Yes ☒ No

☒ House/Mod. Home No. Bedrooms 3

☐ Mobile Home No. Bathrooms 2

☐ Business No. Employees

☐ Other

☐ Slab ☒ Crawl Space ☐ Basement w/plumbing ☐ Basement wo/plumbing


Water Supply: ☐ Individual ☒ Public ☐ Community

Comments:/Conditions:

Comments:/Conditions: ① POLYLOK FILTER INSTALLED ② SYSTEM ALTERED WITH PRIOR HEALTH DEPT APPROVAL

AS BUILT SKETCH

INITIAL SITE SKETCH

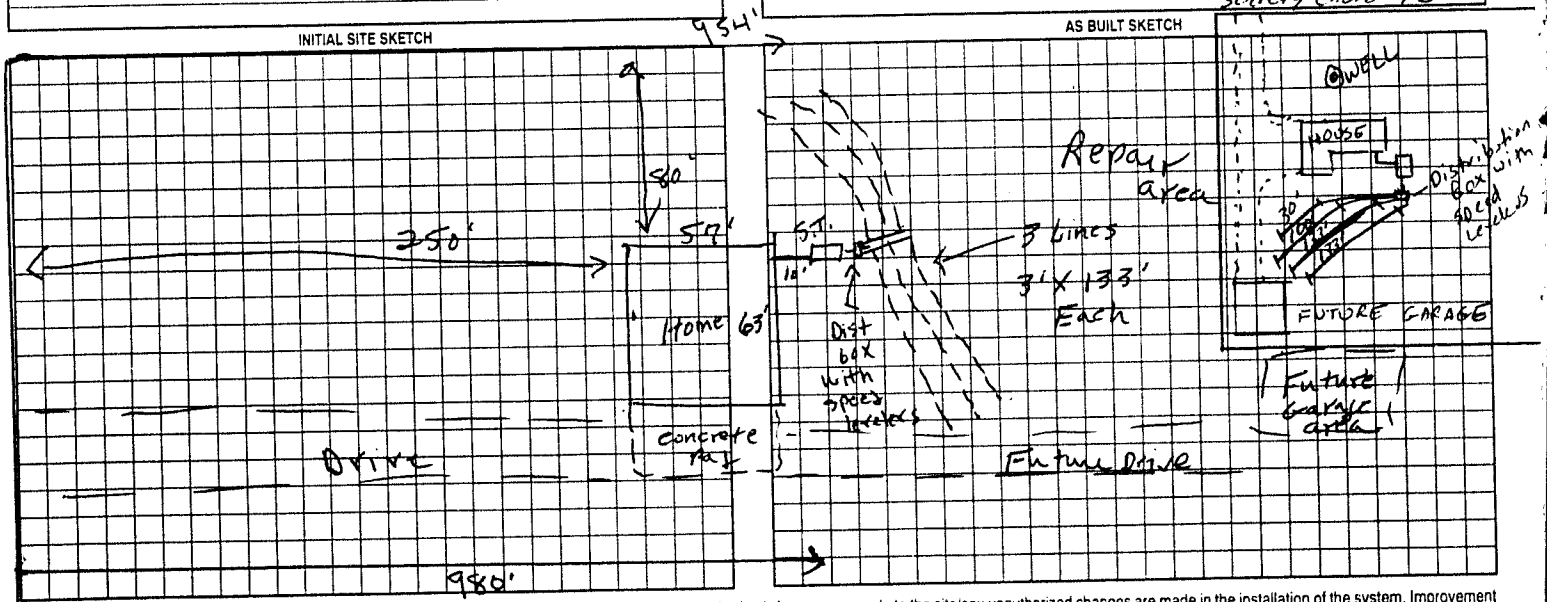

Permit can be suspended or revoked if any false information is supplied toward securing the permit/any unauthorized changes are made to the site/any unauthorized changes are made in the installation of the system. Improvement Permit with plat valid without expiration. Improvement Permit with site plan valid for sixty months. Authorization to Construct is valid for a period equal to that of Improvement Permit – not to exceed sixty months.

Signed: J. Jess Edmonds date

Improvement Permit by: J. C. Moore date 1-31-00

Authorization to Construct by: J. C. Moore date 1-31-00

Installed by: A-1 BACKHOE

Operation Permit by: Joe Cook RSI date 2-1-01

Existing System Inspection by: date

HEALTH DEPT. COPY: WHITE OWNER COPY (FINAL): YELLOW OWNER COPY (INITIAL): PINK