IREDELL COUNTY HEALTH DEPARTMENT

STATESVILLE 704-878-5305 MOORESVILLE 704-664-5281

IMPROVEMENT PERMIT / AUTHORIZATION TO CONSTRUCT / OPERATION PERMIT / EXISTING SYSTEM INSPECTION

PERMIT# 077455 PIN# 4799 10 4181 (PART) DATE 11-5-98

OWNER OR CONTRACTOR BRADLEY H. FOX PHONE: Business Home 336-492-2469

ADDRESS 609 GREENHILL ROAD, MOCKSVILLE, NC 27028

LOCATION OLD MOCKSVILLE ROAD, TR1 SOCIETY CHURCH ROAD, 0.3 MILE ON LEFT

SUBDIVISION JAMES C. GAITHER BLOCK / SECTION LOT 7 LOT AREA 5.05 ACRES SITE CLASS PS DESIGN FLOW 360 L.T.A.R 0.25 GPD/FT²

Septic Tank: 1000 Gallons: STB 312 Date 8-20-99
Pump Tank: Gallons: PT Date
Pump Make: Model Serial No.
Nitrification Field: No. Fields 1 Square Feet 1440 Linear Feet 480
No. Lines FOUR Trench Width 36" Max Trench Bottom Depth 30" Gravel Depth 12"

✓ New System Repair System Type: I II III IV V
System Description CONVENTIONAL GRAVITY
Repair System Description CONV. GRAVITY
Maintenance Agreement Required Yes ✓ No
Slab ✓ Crawl Space Basement w/plumbing Basement w/o plumbing


✓ House/Mod. Home No. Bedrooms 3
Mobile Home No. Bathrooms 3
Business No. Employees
Other

Water Supply: ✓ Individual Public (Community)


Comments/Conditions: KEEP SYSTEM MINIMUM 100' FROM WELL

Comments/Conditions: SYSTEM ALTERED AS SHOWN BELOW,

INITIAL SITE SKETCH SCALE: 1" = 40'

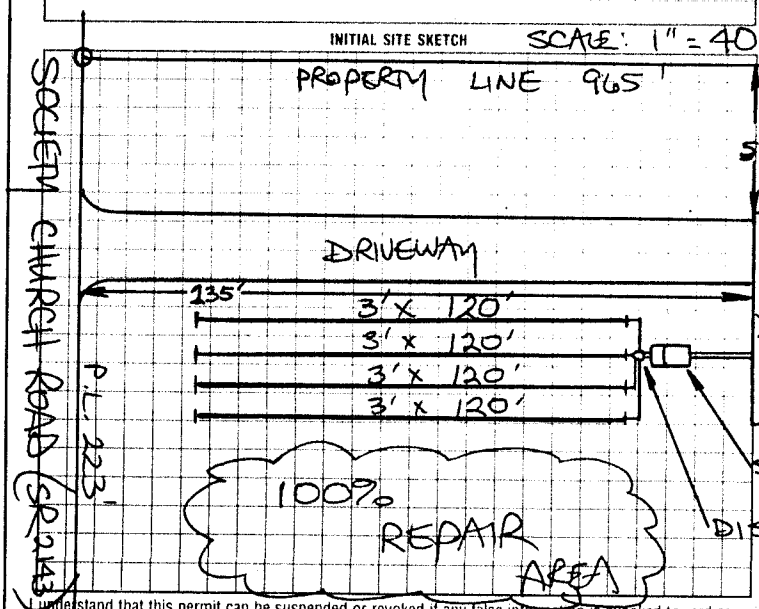

AS BUILT SKETCH

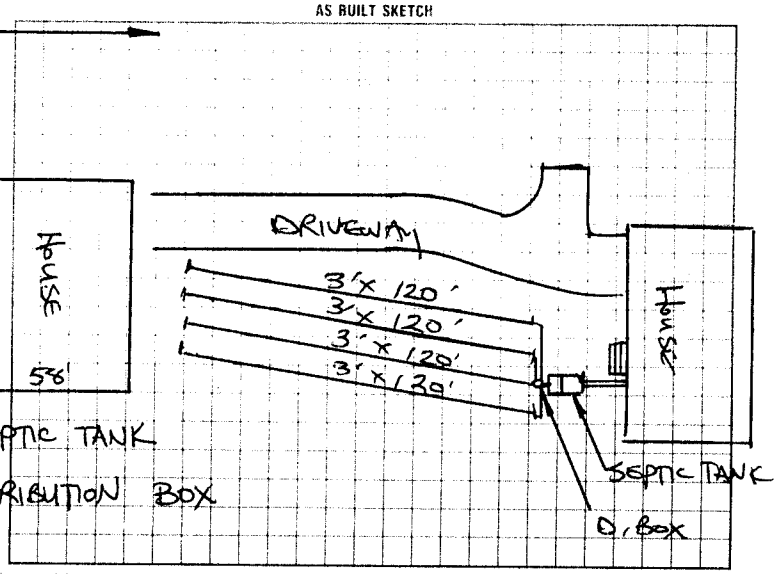

I understand that this permit can be suspended or revoked if any false information is supplied toward securing the permit/any unauthorized changes are made to the site/any unauthorized changes are made in the installation of the system. Improvement Permit with plat valid without expiration. Improvement Permit with site plan valid for sixty months. Authorization to Construct is valid for a period equal to that of Improvement Permit – not to exceed sixty months.

Signed: + Bradley H Fox date 11-5-98

Improvement Permit by: STEVE HEDRICK date 11-5-98

Authorization to Construct by: STEVE HEDRICK date 11-5-98

Installed by: WES LYTTON

Operation Permit by: STEVE HEDRICK date 11-9-99

Existing System Inspection by: date

HEALTH DEPT. COPY: WHITE INSPECTION COPY (FINAL): GREEN OWNER COPY (FINAL): YELLOW INSPECTION COPY (INITIAL): PINK OWNER COPY (INITIAL): GOLD