IREDELL COUNTY HEALTH DEPARTMENT

STATESVILLE 704-878-5305 (C1) MOORESVILLE 704-664-5281

IMPROVEMENT PERMIT / AUTHORIZATION TO CONSTRUCT / OPERATION PERMIT / EXISTING SYSTEM INSPECTION

(C1)

PERMIT# 109178 PIN# 4798-17-7841 DATE 10-17-02

OWNER OR CONTRACTOR FLEETWOOD HOMES OF STATESVILLE PHONE: Business 704-872-9779 Home

ADDRESS 1270 NORNSIDE DR, STATESVILLE NC 28677

LOCATION US 21 N, TR NC 901, TR HAYES FARM ROAD, 0.5 MILE ON RIGHT BEHIND Box # 222

SUBDIVISION BLOCK / SECTION LOT LOT AREA 1.3 ACRES SITE CLASS PS DESIGN FLOW 360 L.T.A.R. 0.25 GAD/FT²

Septic Tank: 1000 Gallons; STB 1012 Date 7-12-02
Pump Tank: Gallons; PT Date
Pump Make: Model Serial No
Nitrification Field: No Fields 1 Square Feet 1440 Linear Feet 480
No Lines SIX Trench Width 36" Max Trench Bottom Depth 36" Gravel Depth 12"

☑ New System ☐ Repair System Type: I II III IV V VI
System Description: CONVENTIONAL GRAVITY
Repair System Description: CONVENTIONAL, GRAVITY
Maintenance Agreement Required: ☐ Yes ☑ NO
☐ Slab ☑ Crawl Space ☐ Basement w/plumbing ☐ Basement wo/plumbing


☐ House/Mod Home No. Bedrooms 3
☑ Mobile Home No. Bathrooms 2
☐ Business No. Employees
☐ Other

Water Supply: ☑ Individual ☐ Public ☐ Community
WELL


Comments/Conditions: ① KEEP SYSTEM MINIMUM 100 FEET FROM EXISTING WELL ② INSTALL SUBSURFACE INTERCEPT DRAINAGE DITCH AT LOCATION SHOWN BEGINNING 48" DEEP SLOPED OUT TO DAYLIGHT

Comments/Conditions: SEPTIC TANK WITH MARKER INSTALLED USING "~~PRESTOK~~" FILTER TUFFTITE

INITIAL SITE SKETCH

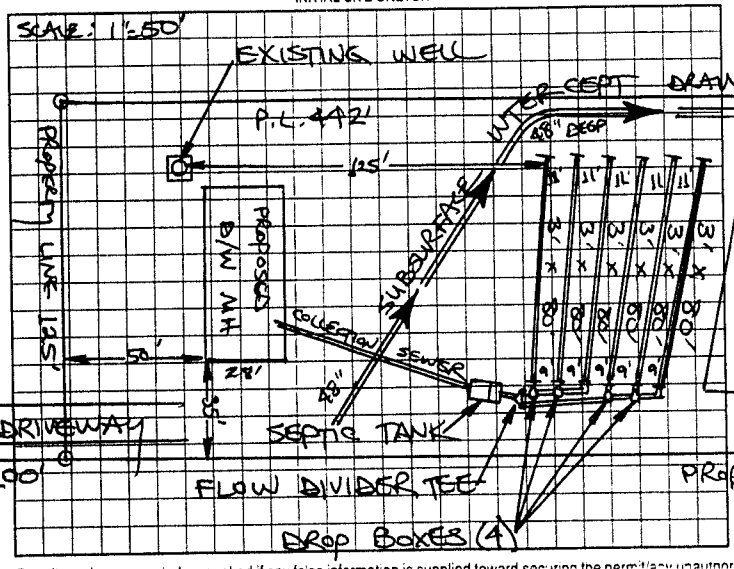

AS BUILT SKETCH

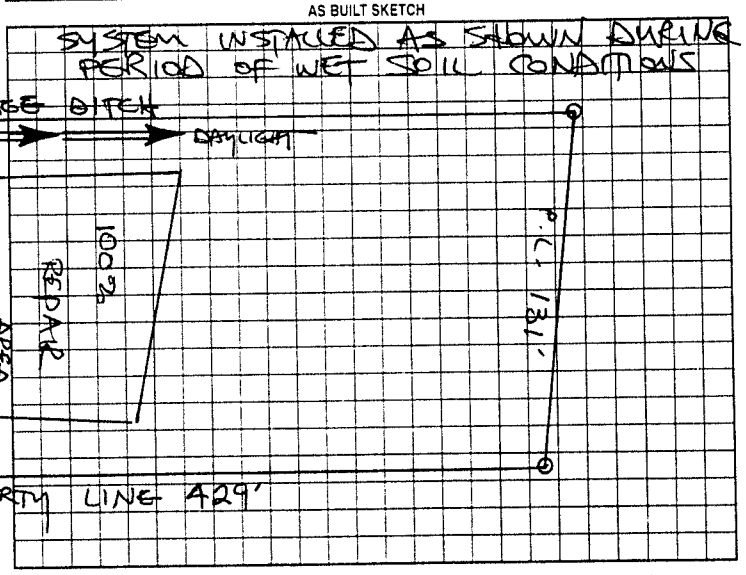

Permit can be suspended or revoked if any false information is supplied toward securing the permit/any unauthorized changes are made to the site any unauthorized changes are made in the installation of the system. Improvement Permit with plat valid without expiration. Improvement Permit with site plan valid for sixty months. Authorization to Construct is valid for a period equal to that of Improvement Permit – not to exceed sixty months

Signed: date 10-18-02 Installed by CRAIG THOMPSON

Improvement Permit by: STEVE HEDRICK date 10-17-02 Operation Permit by: STEVE HEDRICK date 10-22-02

Authorization to Construct by: STEVE HEDRICK date 10-17-02 Existing System Inspection by: date

HEALTH DEPT COPY WHITE OWNER COPY (FINAL) YELLOW OWNER COPY (INITIAL) PINK