IREDELL COUNTY HEALTH DEPARTMENT

THIS PERMIT REPLACES PREVIOUS ISSUED 2-6-04

STATESVILLE 704-878-5305 MOORESVILLE 704-664-5281

IMPROVEMENT PERMIT / AUTHORIZATION TO CONSTRUCT / OPERATION PERMIT / EXISTING SYSTEM INSPECTION

PERMIT# 118134 PIN# 4798-18 ~~5877~~ 3888 DATE 4-30-04

OWNER OR CONTRACTOR ROBERT KELSEY PHONE: Business Home 704-495-5364

ADDRESS 162 KOA LANE, STATESVILLE, NC 28677

LOCATION US 21 NORTH TR NC '901 TR HAYES FARM ROAD 0.4 MILE ON RIGHT

SUBDIVISION JAMES C. GAITHER BLOCK / SECTION LOT 1 LOT AREA 4.235 ACRES SITE CLASS. PS1 DESIGN FLOW 360 L.T.A.R. 0.20GPD/FT²

Septic Tank: 1000 Gallons; STB 1012 Date 2-22-04
Pump Tank: Gallons; PT Date
Pump Make: Model Serial No.
Nitrification Field: No Fields 1 Square Feet 1800 Linear Feet 600
No Lines SIX Trench Width 36" Max Trench Bottom Depth 36" Gravel Depth 12"

☑ New System ☐ Repair System Type: I (II) III, IV, V, VI
System Description: CONVENTIONAL GRAVITY
Repair System Description: 25% REDUCTION
Maintenance Agreement Required: ☐ Yes ☑ No GRAVITY


☑ House/Mod. Home No. Bedrooms 3
☐ Mobile Home No. Bathrooms 2
☐ Business No. Employees
☐ Other
☐ Slab ☑ Crawl Space ☐ Basement w/plumbing ☐ Basement wo/plumbing

Water Supply: ☑ Individual ☐ Public ☐ Community WELL


Comments:/Conditions: KEEP SYSTEM MINIMUM 100 FEET FROM WELL

Comments:/Conditions: SEPTIC TANK WITH MARKER INSTALLED USING "TUFTITE" FILTER

INITIAL SITE SKETCH

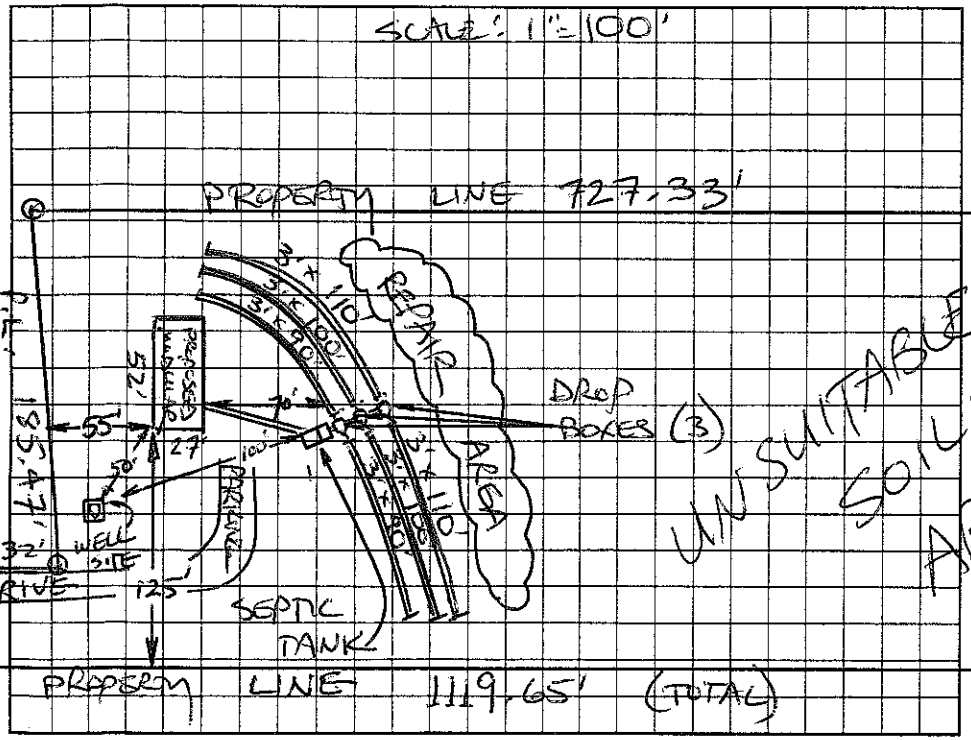

AS BUILT SKETCH

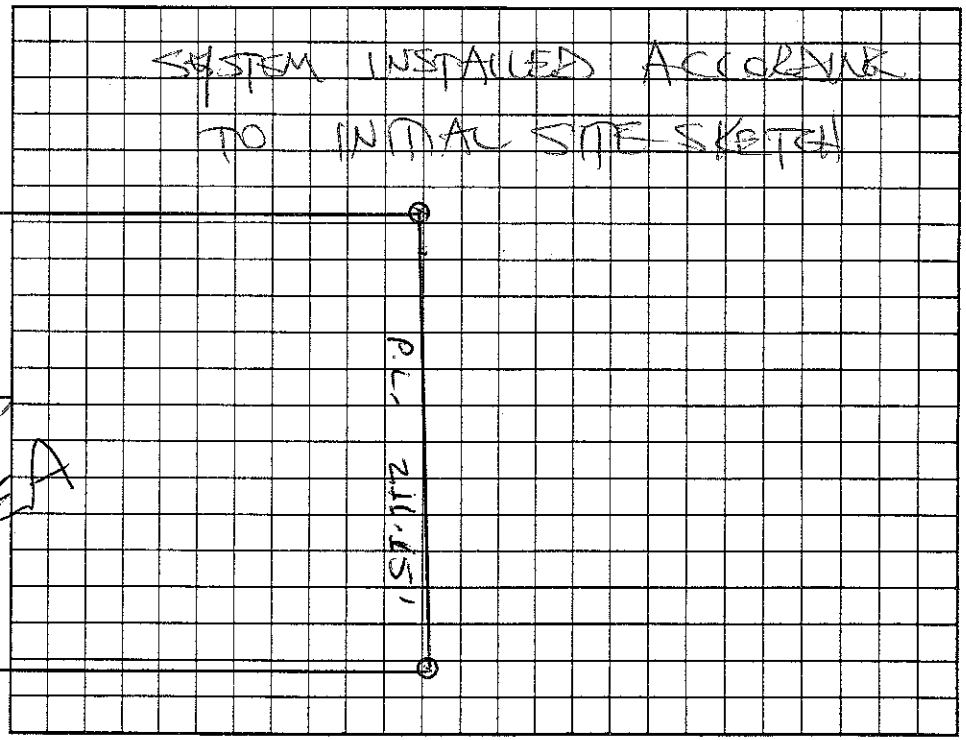

Permit can be suspended or revoked if any false information is supplied toward securing the permit/any unauthorized changes are made to the site/any unauthorized changes are made in the installation of the system. Improvement Permit with plat valid without expiration. Improvement Permit with site plan valid for sixty months. Authorization to Construct is valid for a period equal to that of Improvement Permit – not to exceed sixty months.

Signed: Daniel Hyde date 6/4/04 Installed by: CRAIG THOMPSON

Improvement Permit by: STEVE HEDRICK date 4-30-04 Operation Permit by: STEVE HEDRICK date 7-13-04

Authorization to Construct by: STEVE HEDRICK date 4-30-04 Existing System Inspection by: date

HEALTH DEPT. COPY: WHITE OWNER COPY (FINAL): YELLOW OWNER COPY (INITIAL): PINK