IREDELL COUNTY HEALTH DEPARTMENT

STATESVILLE 704-878-5305 MOORESVILLE 704-664-5281

IMPROVEMENT PERMIT / AUTHORIZATION TO CONSTRUCT / OPERATION PERMIT / EXISTING SYSTEM INSPECTION

PERMIT # REPAIR PIN # 4798-31-5983 DATE APRIL 22, 2010

OWNER or APPLICANT ROBIN BROCK PHONE: Business 336-909-2407 Home: 704-546-5772

OWNER or APPLICANT ADDRESS 168 G & R DRIVE, STATESVILLE NC 28625

LOCATION / DIRECTIONS OLD MOCKSVILLE RD NE, TR SOCIETY ROAD, 2.2 MILES ON (R) AT BOX # 582

SUBDIVISION ____ BLOCK / SECTION ____ LOT # ____ LOT AREA 128'x250' DESIGN FLOW 480 L.T.A.R. 0.30 GPD/FT2

Septic Tank EXISTING Gallons: STB ____ Date ____

Pump Tank ____ Gallons: P T ____ Date ____

Pump Make ____ Model ____ Serial # ____

Nitrification Field No Fields 1 No Lines 5 Linear Feet 300'

Trench Width 36" Max. Trench Bottom Depth 36" Gravel Depth N/A

☐ New System ☑ Repair ☐ Expansion System Type I II (III) IV V VI

System Description: ____

Repair System Description: 25% REDUCTION, GRAVITY

Maintenance Agreement Required ☐ YES ☑ NO

☑ GRAVITY ☐ PRESSURE

☑ Residence No. Bedrooms 4

☐ Business No. Persons 4

☐ Other No. Employees ____

☐ Slab ☐ Crawl Space


☑ Basement w/plumbing ☐ Basement w/o plumbing

Water Supply: ☑ ~~Private~~ ☑ Public ☐ ~~Community~~


Comments / Conditions (1) SUPPLY LINE CROSSES UNDER WATER LINE MINIMUM 18" SEPARATION. (2) SUPPLY LINE CROSSES UNDER AREA SUBJECT TO VEHICULAR TRAFFIC MINIMUM 30" DEEP.

Comments / Conditions (3) INSTALL NEW 25% REDUCTION SYSTEM ON CONTOUR AS SHOWN. (4) FEED EXISTING DRAINFIELD FIRST, THEN SERIALLY TO NEW DRAINFIELD.

INITIAL SITE SKETCH

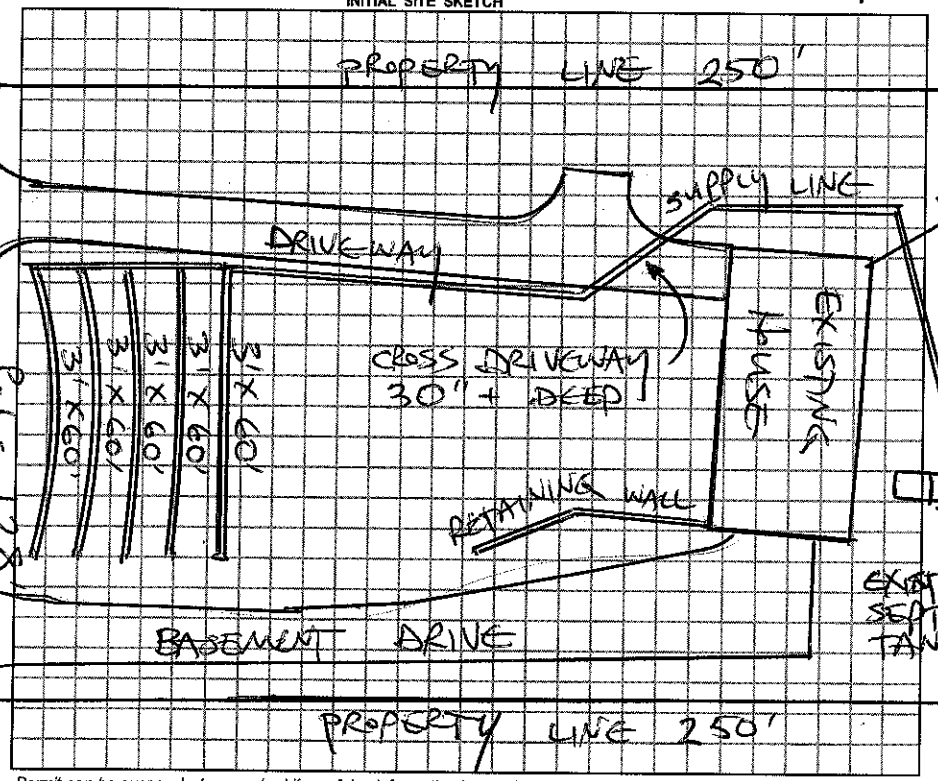

AS BUILT SKETCH

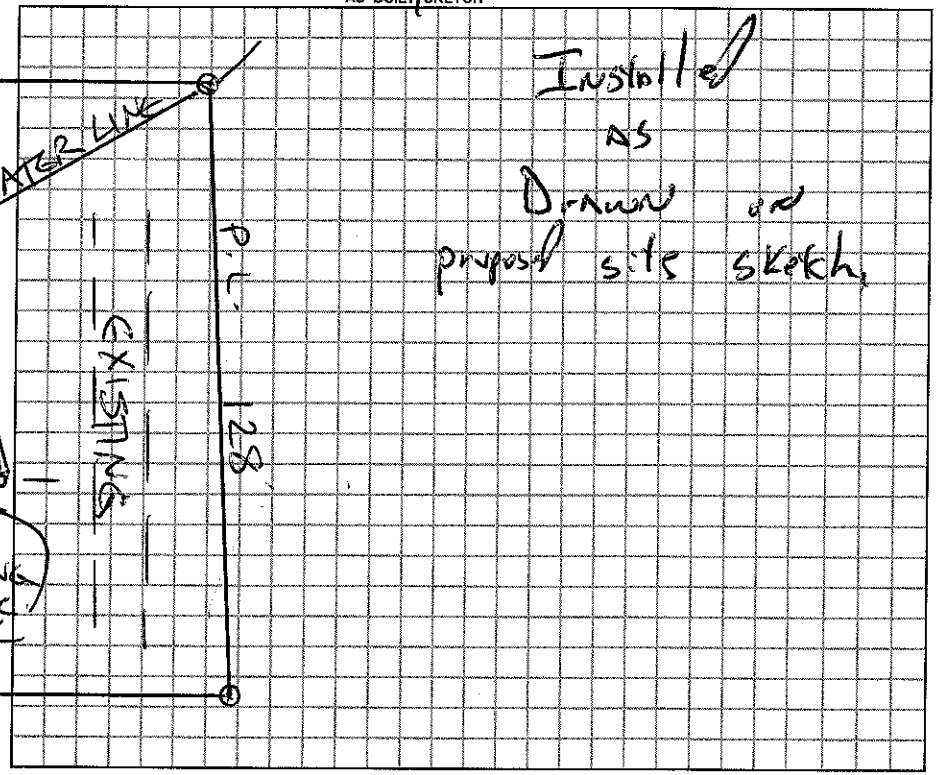

Permit can be suspended or revoked if any false information is supplied toward securing the permit / any unauthorized changes are made to the site / any unauthorized changes are made in the installation of the system.

☐ *IMPROVEMENT PERMIT w / plat valid without expiration.* ☐ *IMPROVEMENT PERMIT w / site plan valid for 60 mos.* ☐ *AUTHORIZATION TO CONSTRUCT valid for period equal to IMPROVEMENT PERMIT-not to exceed 60 mo.*

Owner / Applicant Signature: Robin N. Brock Date 4/22/10

Improvement Permit by: STEVE HENDRICK Date 4/22/2010

Authorzation to Construct by: STEVE HENDRICK Date 4/22/2010

Installed by: Sherman Dunn

Operation Permit by: [signature], R.S. Date: 30 Apr 10

Existing System Inspected by: ____ Date: ____

YOU SHOULD CONTACT A LOCATOR SERVICE PRIOR TO ANY EXCAVATION.

WHITE COPY Environmental Health YELLOW COPY (Final) Owner / Applicant PINK COPY (Initial) Owner / Applicant