IREDELL COUNTY HEALTH DEPARTMENT

STATESVILLE 704-878-5305 MOORESVILLE 704-664-5281

IMPROVEMENT PERMIT / AUTHORIZATION TO CONSTRUCT / OPERATION PERMIT / EXISTING SYSTEM INSPECTION

PERMIT# 149124 PIN# 4798324812

OWNER OR APPLICANT John Jones Jr

ADDRESS 533 30 Cuty Road PHONE: Business 704-929-8351 Home ______ DATE 31 March 08

LOCATION I-40 - Exit 154 - to 64 E (TL) South Church RD 3RD House on right

SUBDIVISION ______ BLOCK / SECTION ______ LOT ______ LOT AREA 2.39 AC SITE CLASS. ______ DESIGN FLOW ______ L.T.A.R. .3

Septic Tank: 1000 Gallons: STB 1012 Date 8-17-07
Pump Tank: ______ Gallons: PT ______ Date ______
Pump Make: ______ Model ______ Serial No. 8-17-07
Nitrification Field: No Fields 1 Square Feet 1200 Linear Feet ~~400~~ 300
No Lines 4 Trench Width 36" Max Trench Bottom Depth 30" Gravel Depth 12

☑ New System ☐ Repair ☐ Expansion, System Type: I (II) III IV V VI
System Description: Conventional Gravity
Repair System Description: 25% Gravity
Maintenance Agreement Required: ☐ Yes ☑ No
☑ Gravity ☐ Pressure

☑ House/Mod. Home ☐ Mobile Home ☐ Business ☐ Other ______
No. Bedrooms 3 No. Persons ______ No. Employees ______

Water Supply: ☑ Individual ☐ Public ☐ Community


☐ Slab ☑ Crawl Space ☑ Basement w/plumbing ☐ Basement wo/plumbing

Comments:/Conditions:

Comments:/Conditions: Abandon Existing Septic System & Install New System as Shown on Contour

INITIAL SITE SKETCH

AS BUILT SKETCH

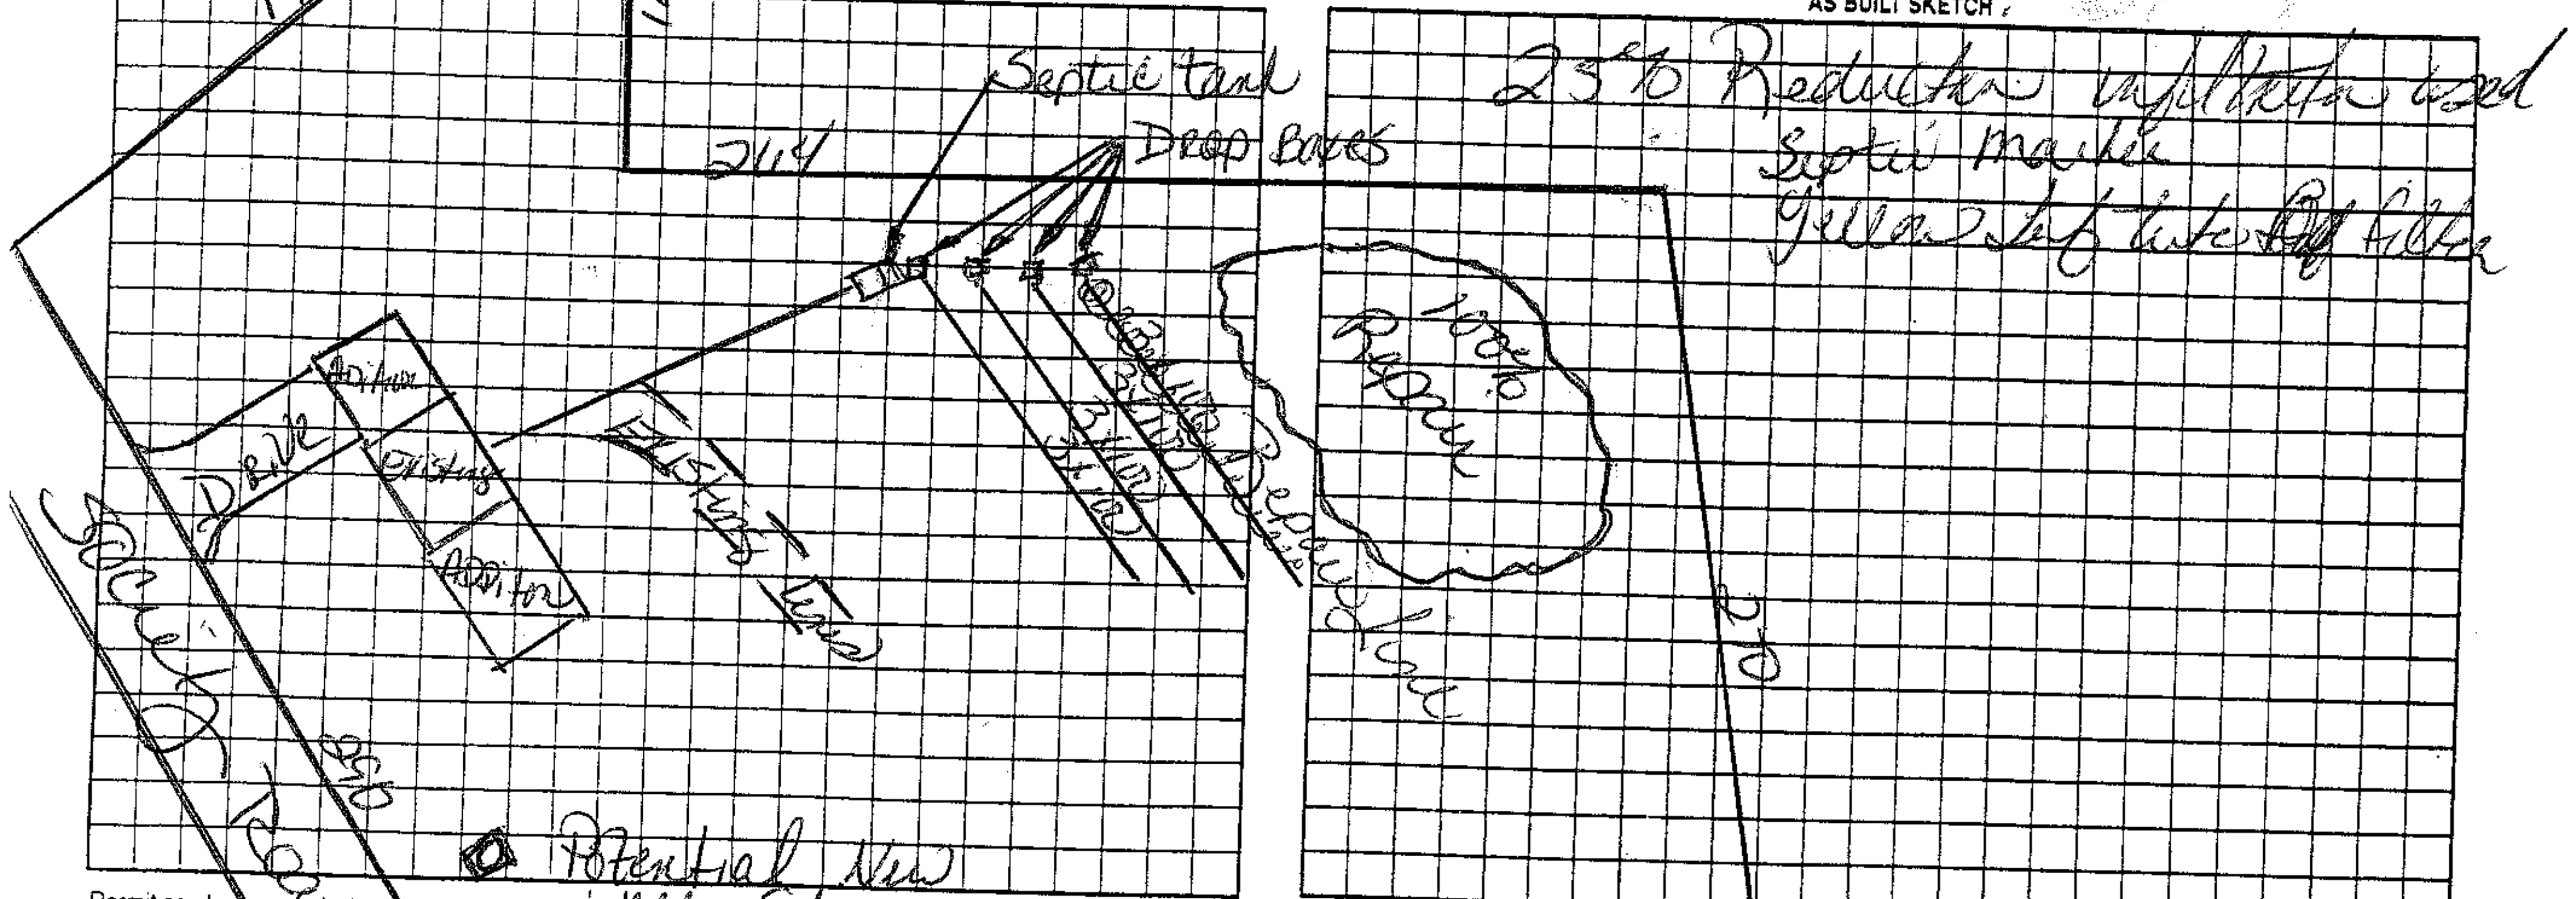

Permit can be suspended or revoked if any false information is supplied toward securing the permit/any unauthorized changes are made to the site/any unauthorized changes are made in the installation of the system. Improvement Permit with plat valid without expiration ☐ Improvement Permit with site plan valid for sixty months ☑ Authorization to Construct is valid for a period equal to that of Improvement Permit – not to exceed sixty months.

Signed: John C. Jones Jr date 3/31/31 Installed by: Craig Thompson

Improvement Permit by: Kelly Cook date 31 March 08 Operation Permit by: Kelly Cook date 5-12-08

Authorization to Construct by: Kelly Cook date 31 March 08 Existing System Inspection by: ______ date ______

HEALTH DEPT. COPY: WHITE OWNER COPY (FINAL): YELLOW OWNER COPY (INITIAL): PINK

298