IREDELL COUNTY HEALTH DEPARTMENT

Statesville Office (704) 878-5305 Mooresville Office (704) 660-3625 PERMIT # 209056

IMPROVEMENT PERMIT / AUTHORIZATION TO CONSTRUCT / OPERATION PERMIT / EXISTING SYSTEM

PIN # 4799209770

APPLICANT: Abee's Clearing & Grading APPLICANT ADDRESS: 2381 US Hwy 64 West Mocksville

SITE ADDRESS: 1390 E. Memorial Hwy. PHONE: 704-239-3693 ALT. PHONE: N/A

SITE DIRECTIONS: Hwy 21 N TR E. Memorial Hwy Property on Right


SUBDIVISION: N/A SECTION: N/A LOT # N/A LOT AREA: 77.3 acres DESIGN FLOW: 360gpd L.T.A.R.: 0.25

Septic Tank	1000 (gal)	STB	1000-760	Date	1-9	☑ New System	☐ Repair	☐ Expansion	System Type: I II (III) IV V VI	☑ Residence	No. Bedrooms 3
Pump Tank	(gal)	PT		Date		System Description:	25% Reduction			☐ Business	No. Persons 6
Pump Make		Model		Serial #		Repair System Description:	25% Reduction			☐ Other	No. Employees
# Nitrification Fields	1	# Lines	4	Linear Ft:	360	Maintenance Agreement Required:	☐ YES	☑ NO		☐ Slab	☑ Crawl Space
Trench Width	36"	Max. Trench Bottom Depth	30"	Gravel Depth	N/A		☑ GRAVITY	☐ PRESSURE		☐ Basement w/plumbing	☐ Basement w/o plumbing

Water Supply: ☐ Private ☑ Public ☐ Community

Comments / Conditions: Install a 25% Reduction system on contour with serial distribution.

INITIAL SITE SKETCH

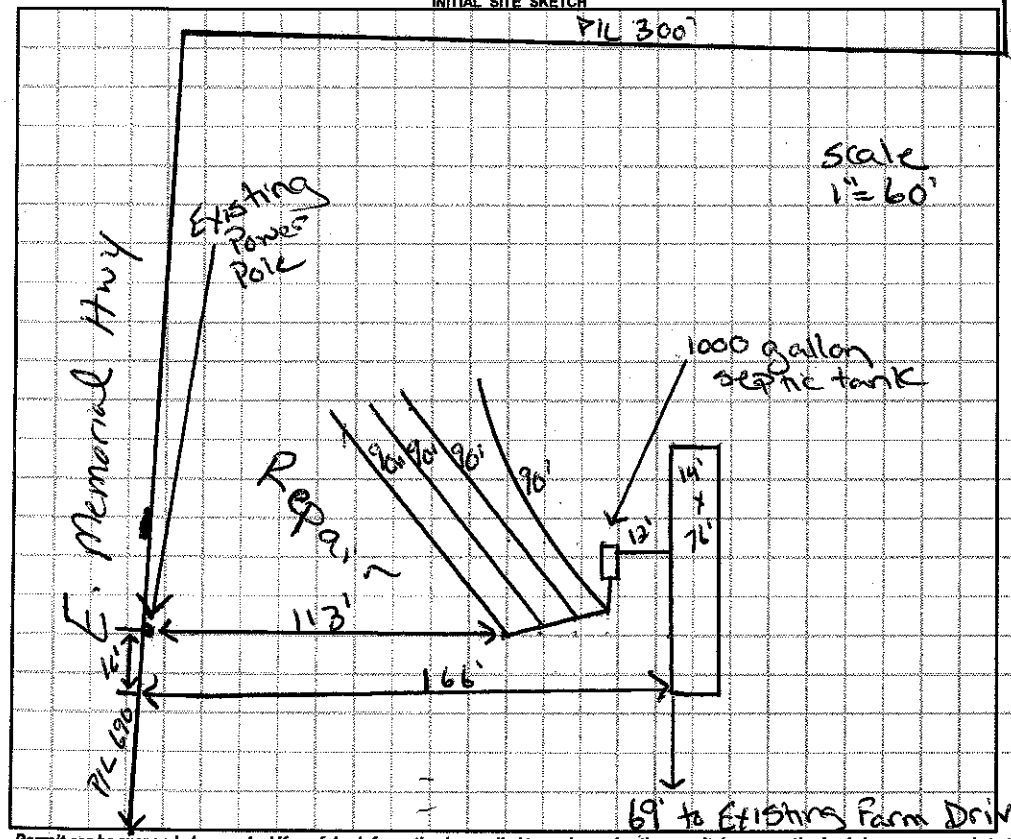

AS BUILT SKETCH

- Red Poly/or filter installed
- Arc 36 Chambers installed
- Installed as Drawn

Permit can be suspended or revoked if any false information is supplied toward securing the permit / any unauthorized changes are made to the site / any unauthorized changes are made in the installation of the system. **CONTACT A LOCATOR SERVICE PRIOR TO ANY EXCAVATION**

☐ **IMPROVEMENT PERMIT** *with plat valid without expiration.* ☑ **IMPROVEMENT PERMIT** *with site plan valid for 60 mos.* ☑ **AUTHORIZATION TO CONSTRUCT** *valid for period equal to IMPROVEMENT PERMIT--not to exceed 60 mo.*

Owner / Applicant Signature: Deana Abee Date: 4/20/15 Installed by: Tim Abee

IMPROVEMENT PERMIT by: Justin Henderson Date: 4-13-15 OPERATION PERMIT by: Justin Henderson Date: 5-13-15

AUTHORIZATION TO CONSTRUCT by: Justin Henderson Date: 4-13-15 Existing System Inspected by: Date:

Health Dept. Copy - WHITE Applicant (Final Approval) - YELLOW Applicant (Conditional Approval) - PINK