# IREDELL COUNTY HEALTH DEPARTMENT - *ENVIRONMENTAL HEALTH*

☒ STATESVILLE OFFICE 704-878-5305 ☐ MOORESVILLE OFFICE 704-664-5281

## IMPROVEMENT PERMIT / AUTHORIZATION TO CONSTRUCT / OPERATION PERMIT / EXISTING SYSTEM INSPECTION

PERMIT # 175869 PIN # 4798401799 DATE 11/15/12

OWNER Trustees of Society Baptist APPLICANT: Deena Abee PHONE: Home/Cell # 336-240-8298 Business # 704-239-3693

SITE ADDRESS 879 Garden Valley Rd OWNER / APPLICANT ADDRESS

SITE DIRECTIONS 64E to (L) on Society Rd, (L) on Garden Valley - House on (R) on corner

SUBDIVISION n/a BLOCK / SECTION n/a LOT # n/a LOT AREA 4.69 Ac. DESIGN FLOW 360 L.T.A.R. .3

Septic Tank 1000 Gallons: STB 760 Date 7-31

Pump Tank Gallons: P T Date

Pump Make Model Serial #

No. Nitrification Fields: 1 No. Lines 3 Linear Feet 300

Trench Width 36" Max. Trench Bottom Depth 36"

☒ New System ☒ Repair ☐ Expansion System Type I II (III) IV V VI

System Description: 25%

Repair System Description: 25% Reduction Gravity

Maintenance Agreement Required ☐ YES ☒ NO

Gravel Depth n/a ☒ GRAVITY ☐ PRESSURE

☒ Residence No. Bedrooms 3

☐ Business No. Persons

☐ Other No. Employees


☐ Slab ☐ Crawl Space

☐ Basement w/plumbing ☒ Basement w/o plumbing


Water Supply: ☒ Private ☐ Public ☐ Community

Comments / Conditions: Replumb house to allow plumbing exit side of house at higher elevation

INITIAL SITE SKETCH

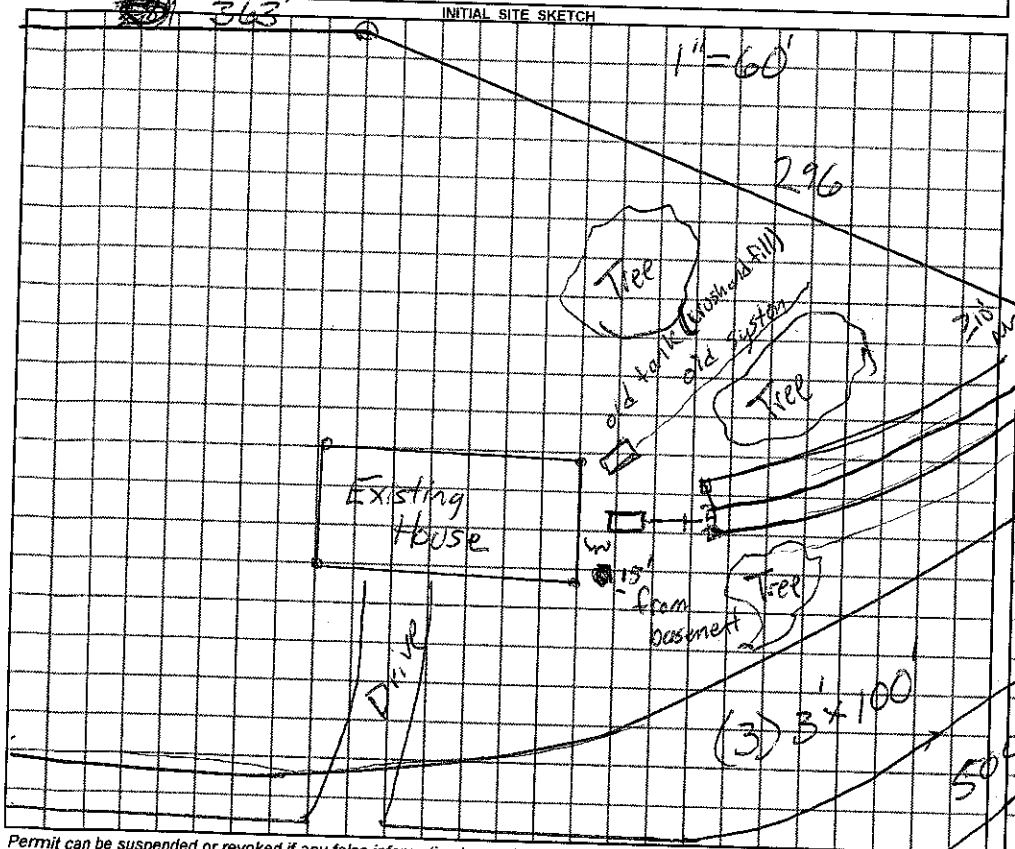


AS BUILT SKETCH

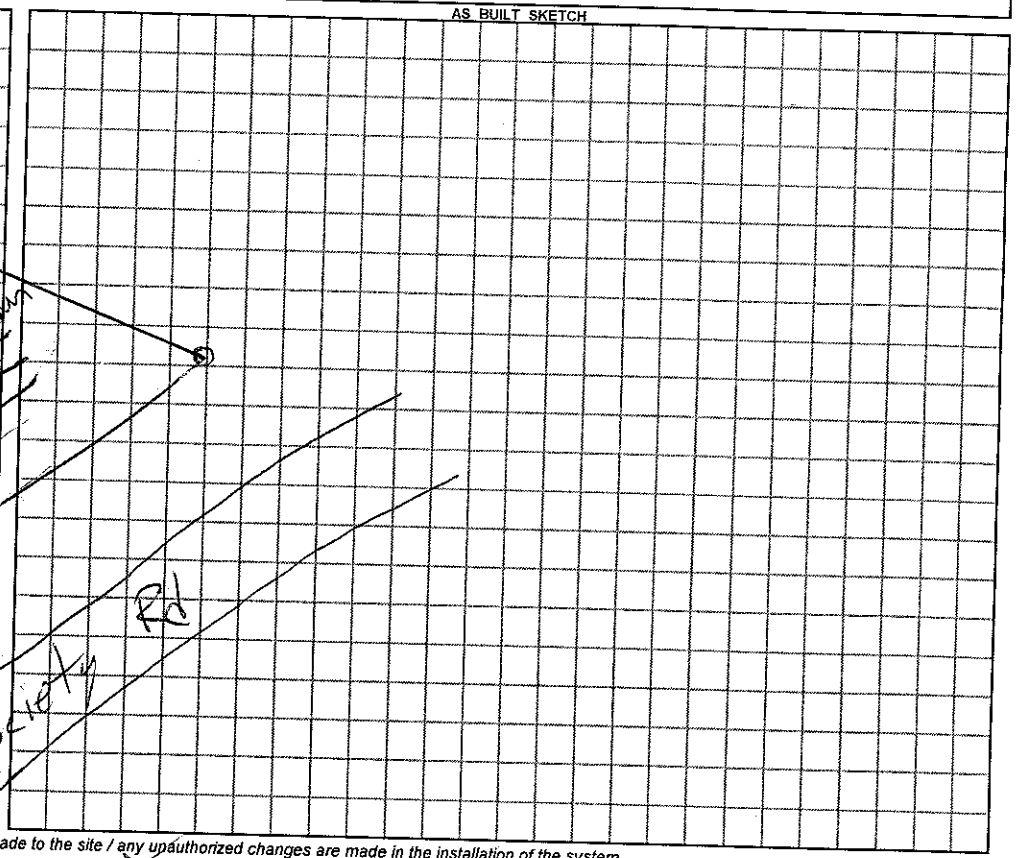

*Permit can be suspended or revoked if any false information is supplied toward securing the permit / any unauthorized changes are made to the site / any unauthorized changes are made in the installation of the system.*

☐ *IMPROVEMENT PERMIT with plat valid without expiration.* ☒ *IMPROVEMENT PERMIT with plat valid without expiration. Site plan valid 60 mo.* ☒ *AUTHORIZATION TO CONSTRUCT* valid for period equal to IMPROVEMENT PERMIT--not to exceed 60 mo.

Owner / Applicant Signature: Deena Abee Date 11/16/12 Installed by: Abee Grading

IMPROVEMENT PERMIT by: REHS Date 11-16-12 OPERATION PERMIT by: REHS Date 11-21-12

AUTHORIZATION TO CONSTRUCT by: REHS Date 11-16-12 Existing System Inspected by: REHS Date

***YOU SHOULD CONTACT A LOCATOR SERVICE PRIOR TO ANY EXCAVATION***

White Copy – Environmental Health YELLOW COPY (Final) Owner / Applicant PINK COPY (Initial) Owner / Applicant