IREDELL COUNTY HEALTH DEPARTMENT

THIS PERMIT VOIDS PREVIOUS ISSUED 8-19-03

STATESVILLE 704-878-5305 MOORESVILLE 704-664-5281

IMPROVEMENT PERMIT / AUTHORIZATION TO CONSTRUCT / OPERATION PERMIT / EXISTING SYSTEM INSPECTION

PERMIT# 114852 PIN# 4799-00-8525 DATE 8-27-03

OWNER OR CONTRACTOR CHARLES BLANKENSHIP PHONE: Business Home 704-546-5600

ADDRESS 7850 OLD MOCKSVILLE ROAD, STATESVILLE, NC 28625

LOCATION OLD MOCKSVILLE ROAD NE, HOUSE ON RIGHT PAST SOCIETY CHURCH ROAD

SUBDIVISION BLOCK / SECTION LOT LOT AREA 8 ACRES SITE CLASS. #5 DESIGN FLOW 360 L.T.A.R. 0.30 GPD/FT

Septic Tank: ~~EXISTING~~ Gallons; STB Date

Pump Tank: Gallons; PT Date

Pump Make: Model Serial No.

Nitrification Field: No Fields 1 Square Feet 600 Linear Feet 200

No Lines TWO Trench Width 36" Max Trench Bottom Depth 36" Gravel Depth 12"

☐ New System ☐ Repair System Type: I, II, III, IV, V, VI

System Description: CONVENTIONAL GRAVITY

Repair System Description: CONV. GRAVITY

Maintenance Agreement Required: ☐ Yes ☒ ~~No~~

☒ House/Mod. Home No. Bedrooms 3

☐ Mobile Home No. Bathrooms 2

☐ Business No. Employees

☐ Other


☐ Slab ☒ Crawl Space ☐ Basement w/plumbing ☐ Basement wo/plumbing

Water Supply: ☒ Individual ☐ ~~Public~~ ☐ Community WELL

Comments:/Conditions: DISCONNECT UPPER TWO DRAINLINES AT DISTRIBUTION BOX. INSTALL NEW DROP BOXES AT LOCATION SHOWN SERIALLY FEEDING TWO NEW 3'x 100' LINES ON CONTOUR

Comments:/Conditions:

INITIAL SITE SKETCH

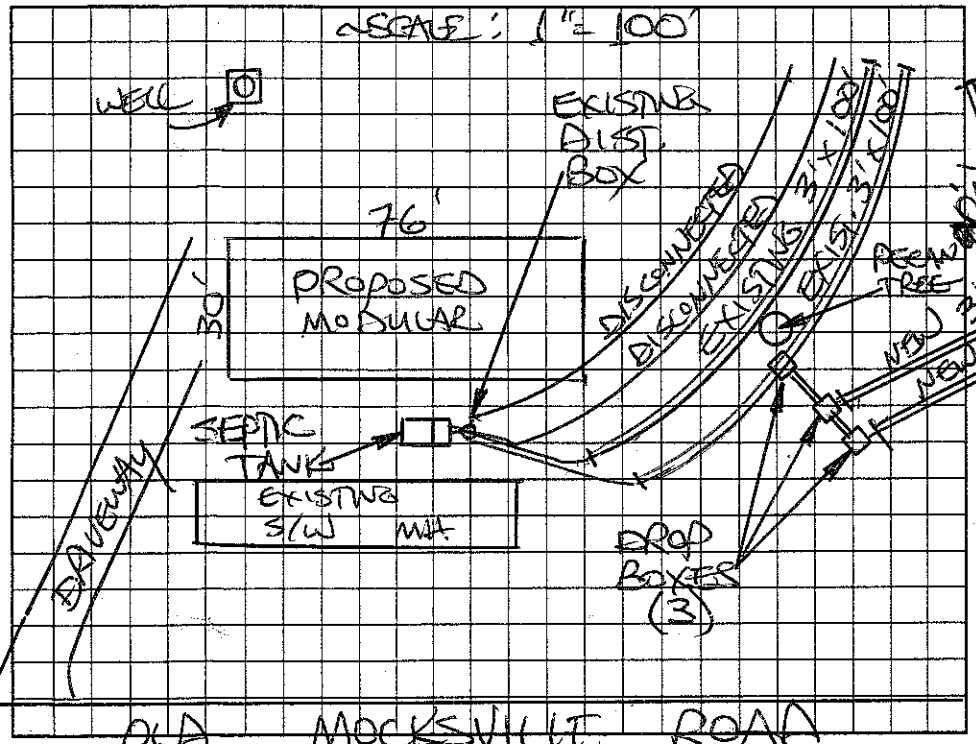

AS BUILT SKETCH

LINE LENGTHS CHANGED TO 80'x 100'. FIRST LINE WOULD HAVE BEEN IN EXISTING LINES IF 100' LONG.

INSTALLED AS DRAWN

Permit can be suspended or revoked if any false information is supplied toward securing the permit/any unauthorized changes are made to the site/any unauthorized changes are made in the installation of the system. Improvement Permit with plat valid without expiration. Improvement Permit with site plan valid for sixty months. Authorization to Construct is valid for a period equal to that of Improvement Permit – not to exceed sixty months.

Signed: x Doug Blankenship date 8-27-03

Improvement Permit by: STEVE HEDRICK date 8-27-03

Authorization to Construct by: STEVE HEDRICK date 8-27-03

Installed by: STEVE JORDAN

Operation ~~Permit~~ by: RS date 9-3-03

Existing System Inspection by: date

HEALTH DEPT. COPY: WHITE OWNER COPY (FINAL): YELLOW OWNER COPY (INITIAL): PINK