IREDELL COUNTY HEALTH DEPARTMENT - *ENVIRONMENTAL HEALTH* ☐ STATESVILLE OFFICE 704-878-5305 ☑ ☐ MOORESVILLE OFFICE 704-664-5281

IMPROVEMENT PERMIT / AUTHORIZATION TO CONSTRUCT / OPERATION PERMIT / EXISTING SYSTEM INSPECTION

PERMIT # 172757 PIN # 4799-018-554 DATE JUNE 12, 2012

OWNER ALLEN + EMILY HAGER APPLICANT: CLAYTON HOMES PHONE: Home/Cell # 704-239-3693 Business # 704-873-2547

SITE ADDRESS 1258 EAST MEMORIAL HWY OWNER / APPLICANT ADDRESS 1258 EAST MEMORIAL HWY. HARMONY, NC 28634

SITE DIRECTIONS HWY 21 N (R) E. MEMORIAL HWY, PROPERTY ON (R) DIRECTLY ACROSS FROM PLEASANT VIEW BAPTIST CH.

SUBDIVISION NA BLOCK / SECTION NA LOT # NA LOT AREA 1 AC. DESIGN FLOW 480 L.T.A.R. 0.30 GPD

Septic Tank 1000 Gallons: STB Ex Date Ex
Pump Tank ____ Gallons: P T ____ Date ____
Pump Make ____ Model ____ Serial # ____
No. Nitrification Fields: ____ No. Lines 2 Linear Feet 200
Trench Width 36" Max. Trench Bottom Depth 36" Gravel Depth N/A


☐ New System ☐ Repair ☒ Expansion System Type I II (III) IV V VI
System Description: 25% REDUCTION
Repair System Description: 25% REDUCTION
Maintenance Agreement Required ☐ YES ☒ NO
☒ GRAVITY ☐ PRESSURE

☒ Residence No. Bedrooms 4
☐ Business No. Persons ____
☐ Other No. Employees ____
☐ Slab ☒ Crawl Space
☐ Basement w/plumbing ☐ Basement w/o plumbing

Water Supply: ☐ Private ☒ Public ☐ Community

Comments / Conditions
INSTALL 25% REDUCTION SYSTEM ON CONTOUR AS SHOWN
USE ONE FLOW DIVIDER TO ACHIEVE EQUAL DISTRIBUTION INTO ~~EXISTING~~ NEW DRAWLINES

INITIAL SITE SKETCH

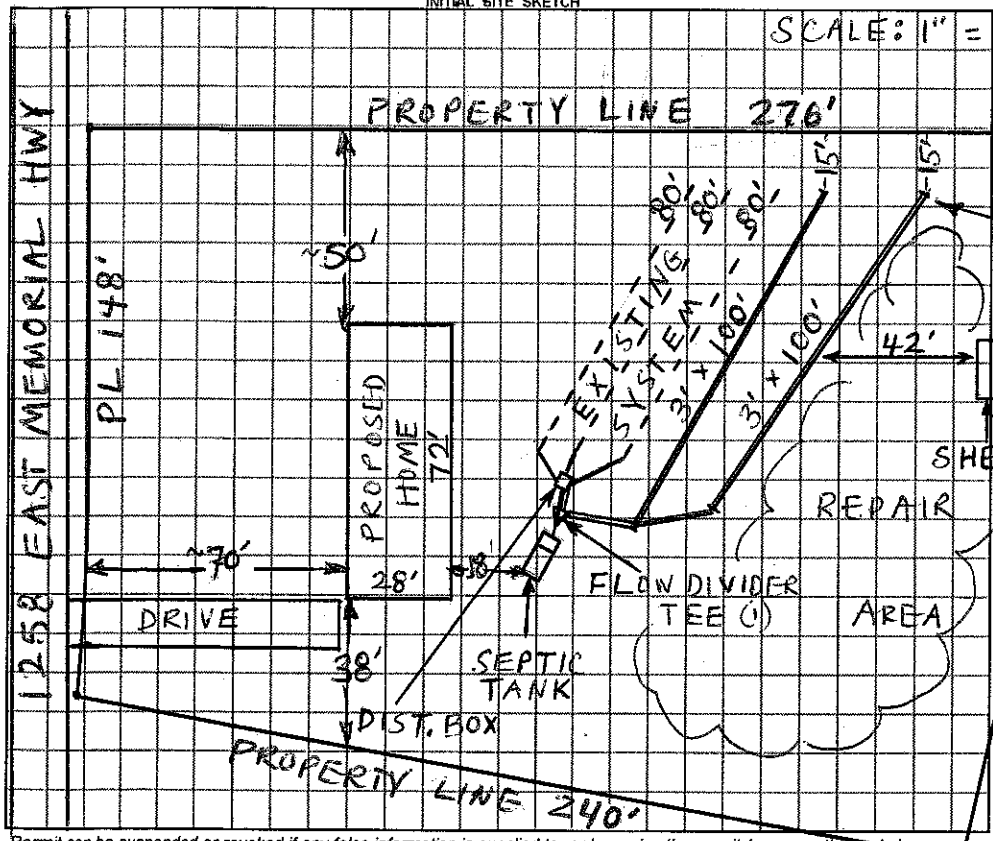

AS BUILT SKETCH

Permit can be suspended or revoked if any false information is supplied toward securing the permit / any unauthorized changes are made to the site / any unauthorized changes are made in the installation of the system.

☐ ***IMPROVEMENT PERMIT*** *with plat valid without expiration.* ☒ ***IMPROVEMENT PERMIT*** *with plat valid without expiration. site plan valid 60 mo.* ☒ ***AUTHORIZATION TO CONSTRUCT*** valid for period equal to IMPROVEMENT PERMIT–not to exceed 60 mo.

Owner / Applicant Signature: Sarah Blackwell Date 6-18-12 Installed by: Abee Grading

IMPROVEMENT PERMIT by: Kimberly Meeusen #1377 REHS Date 6-12-12 OPERATION PERMIT by: REHS Date 7-3-12

AUTHORIZATION TO CONSTRUCT by: Kimberly Meeusen REHS Date 6-12-12 Existing System Inspected by: REHS Date

YOU SHOULD CONTACT A LOCATOR SERVICE PRIOR TO ANY EXCAVATION

White Copy – Environmental Health YELLOW COPY (Final) Owner / Applicant PINK COPY (Initial) Owner / Applicant