IREDELL COUNTY HEALTH DEPARTMENT

(SEPTIC TANK) IMPROVEMENTS PERMIT AND CERTIFICATE OF COMPLETION
(Ground Absorption Sewage Disposal System -- G. S. Chapter 130-Article 13C)

OWNER OR CONTRACTOR Earl Dobson, JR. DATE 11-11-74 PERMIT NO.

PHONE: Business Home

LOCATION 9012 1/2 E. Harmony, beside Parker Repping

S. R. No 501


SUBDIVISION NAME LOT NO. SECTION OR BLOCK NO

Use: Residence ( ) Mobile Home ( ) Business ( ) Other:

No. Bedrooms 2 No. Bathrooms 1

Garbage Disposal Unit: Yes ( ) No ( )
Auto. Dishwasher: Yes ( ) No ( )
Auto. Wash. Machine: Yes ( ) No ( )
Site Suitable: Yes ( ) No ( )
Lot Area 1/2 Acre

Character & Porosity of Soil Red Clay
Percolation Rate
Topography Slight slope to back
Depth to Water Table
Rock or other impervious formations None

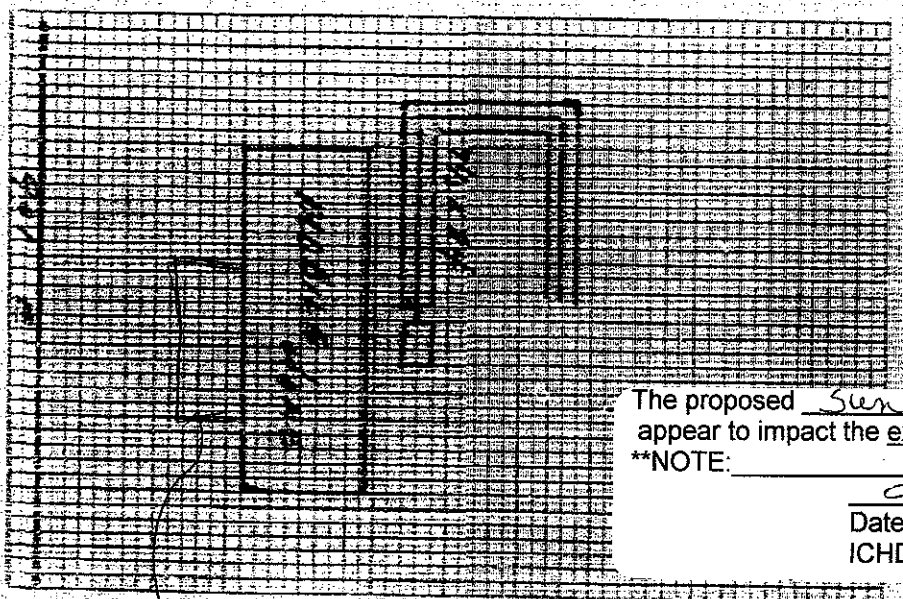

Size of Tank Less Gals.
Nitrification Field:
No. of Lines 3
Sq. Ft. 625 Linear Ft. 2
Depth of Stone in Lines 10"
Water Supply: Individual ( )
Public ( )

Installed by

The proposed Sun Room addition does not appear to impact the existing septic system.
**NOTE:

R.S.
Date: 5-5-09
ICHD-Environmental Health Division

Plan of System

IMPROVEMENTS PERMIT BY

COMMENTS

CERTIFICATE OF COMPLETION BY DATE

CONSTRUCTION MUST COMPLY WITH ALL OTHER APPLICABLE STATE AND LOCAL REGULATIONS

Health Department Copy: White Inspection Dept. Copy: Yellow Sanitarian's Copy: Pink Owner's Copy: Gold

JAN. 13, 1989 17:12