IREDELL COUNTY HEALTH DEPARTMENT

STATESVILLE 704-878-5305 MOORESVILLE 704-664-5281

IMPROVEMENT PERMIT / AUTHORIZATION TO CONSTRUCT / OPERATION PERMIT / EXISTING SYSTEM INSPECTION

PERMIT# REPAIR PIN# 4799 04 8714 DATE 2-14-00

OWNER OR CONTRACTOR PARKS M. JONES PHONE: Business 546-2510 Home

ADDRESS 668 RIMROCK ROAD, STATESVILLE NC 28625

LOCATION US 21 NORTH, TR NC 901, MH ON LEFT AT BOX # 1105

SUBDIVISION BLOCK / SECTION LOT LOT AREA AMPLE +/- 1.5 AC. SITE CLASS PS DESIGN FLOW 360 L.T.A.R. ~0.35 GPD/FT²

Septic Tank: 1000 Gallons: STB 1012 Date 2-25-00
Pump Tank: Gallons: PT Date
Pump Make: Model Serial No.
Nitrification Field: No Fields 1 Square Feet 950 Linear Feet 350
No Lines FOUR Trench Width 36" Max Trench Bottom Depth 36" Gravel Depth 12"

~~Construction~~ ☒ Repair System Type: I (II, III, IV, V, VI)
System Description: CONVENTIONAL, GRAVITY
Repair System Description: CONV, GRAVITY
Maintenance Agreement Required: ☐ Yes ☒ No

☐ House/Mod. Home ☒ Mobile Home ☐ Business ☐ Other
No. Bedrooms 3 No. Bathrooms 2 No. Employees


☐ Slab ☒ Crawl Space ☐ Basement w/plumbing ☐ Basement wo/plumbing

Water Supply: ☐ Individual ☐ Public ☐ Community


Comments/Conditions: ① THIS PERMIT ~~SERVES~~ AS NOTICE OF VIOLATION - SYSTEM TO BE REPAIRED BY 3-15-2000
② ABANDON EXISTING FAILING SYSTEM

Comments/Conditions: ① SYSTEM ALTERED AS SHOWN BELOW WITH PRIOR HEALTH DEPT. APPROVAL DUE TO LOCATION OF EXISTING UNDERGROUND POWER LINE.
② SEPTIC TANK W/ RISERS & MARKER & "Poylok" FILTER INSTALLED.

INITIAL SITE SKETCH

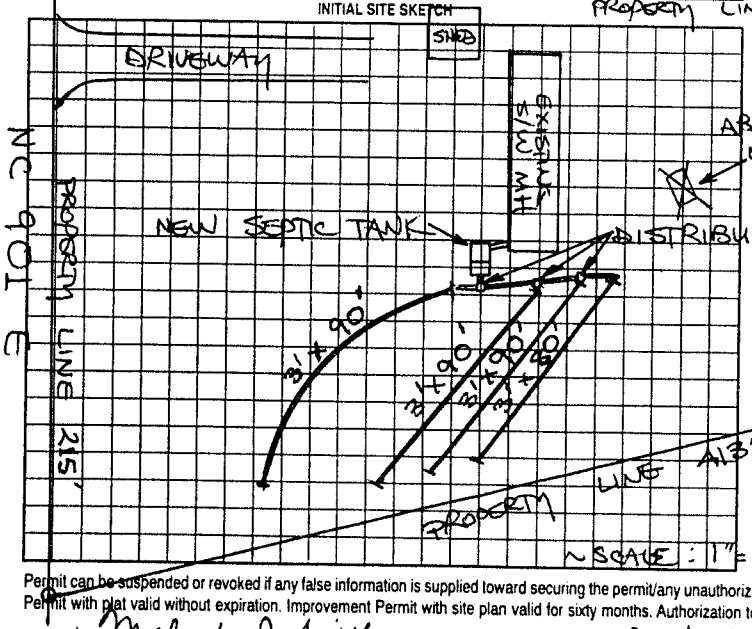

AS BUILT SKETCH

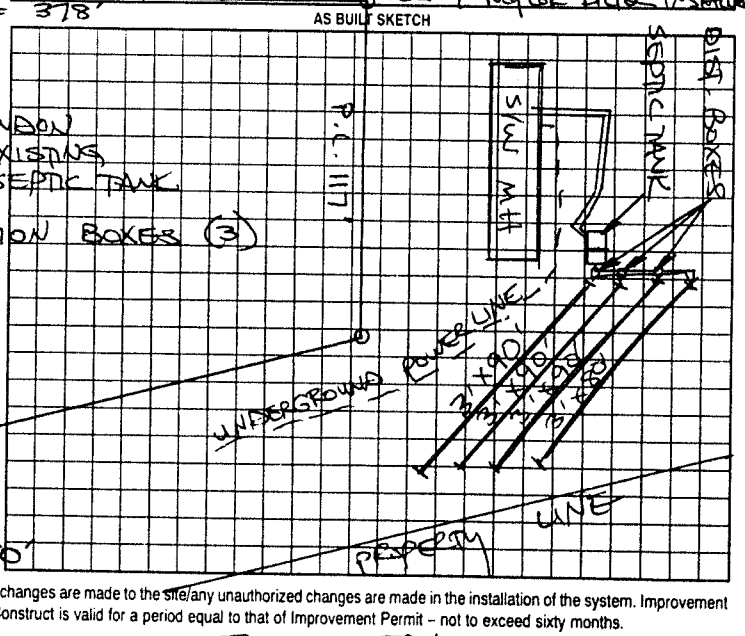

Permit can be suspended or revoked if any false information is supplied toward securing the permit/any unauthorized changes are made to the site/any unauthorized changes are made in the installation of the system. Improvement Permit with plat valid without expiration. Improvement Permit with site plan valid for sixty months. Authorization to Construct is valid for a period equal to that of Improvement Permit – not to exceed sixty months.

Signed Malinda J. Smith date 2-14-00 Installed by: TOMMY FRYE

Improvement Permit by: STEVE HEDRICK date 2-14-00 Operation Permit by: STEVE HEDRICK date 2-25-00

Authorization to Construct by: STEVE HEDRICK date 2-14-00 Existing System Inspection by: date

HEALTH DEPT. COPY: WHITE OWNER COPY (FINAL): YELLOW OWNER COPY (INITIAL): PINK