IREDELL COUNTY HEALTH DEPARTMENT

STATESVILLE 704-878-5305 MOORESVILLE 704-664-5281

IMPROVEMENT PERMIT / AUTHORIZATION TO CONSTRUCT / OPERATION PERMIT / EXISTING SYSTEM INSPECTION

PERMIT# 083769 PIN# 4799 06 4070 DATE 9-16-99

OWNER OR CONTRACTOR MILDRED J. KELLER PHONE: Business Home 546-2394

ADDRESS 1038 W. MEMORIAL HWY; HARMONY, NC 28634

LOCATION US 21 NORTH, TR [redacted] NC 901; ON RIGHT AT BOX # 1052 (PAST GUILFORD RD)

SUBDIVISION BLOCK / SECTION LOT LOT AREA 2.12 ACRES SITE CLASS. PS DESIGN FLOW 340 L.T.A.R. 0.35 GPD/FT²

Septic Tank: EXISTING Gallons: STB Date

Pump Tank: Gallons: PT Date

Pump Make: Model Serial No.

Nitrification Field: No Fields 1 Square Feet 285 Linear Feet 95'

No Lines ONE Trench Width 36" Max Trench Bottom Depth 36" Gravel Depth 12"

☑ New System ☐ Repair System Type: I II III IV V VI

System Description: CONVENTIONAL GRAVITY

Repair System Description: 25% REDUCTION GRAVITY

Maintenance Agreement Required: ☐ Yes ☑ No

☐ Slab ☑ Crawl Space ☐ Basement w/plumbing ☐ Basement wo/plumbing

☐ House/Mod. Home No. Bedrooms 2

☐ Mobile Home No. Bathrooms 2

☐ Business No. Employees


Other W/1 OFFICE

Water Supply: ☐ Individual ☑ Public ☐ Community

Comments/Conditions: ① INSTALL TWO NEW DROP BOXES AT LOCATIONS SHOWN TO PROVIDE FOR SERIAL DISTRIBUTION ② INSTALL NEW 3' x 95' LINE ON CONTOUR AS FLAGGED

Comments/Conditions

INITIAL SITE SKETCH

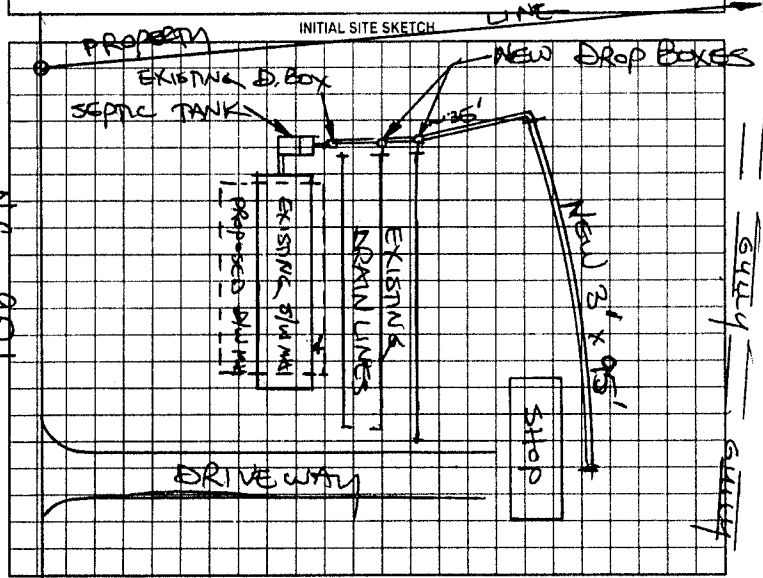

AS BUILT SKETCH

SYSTEM EXPANDED ACCORDING TO INITIAL SITE SKETCH

Permit can be suspended or revoked if any false information is supplied toward securing the permit/any unauthorized changes are made to the site/any unauthorized changes are made in the installation of the system. Improvement Permit with plat valid without expiration. Improvement Permit with site plan valid for sixty months. Authorization to Construct is valid for a period equal to that of Improvement Permit – not to exceed sixty months.

Signed: [signature] date 9-16-99

Improvement Permit by: STEVE HEDRICK date 9-16-99

Authorization to Construct by: STEVE HEDRICK date 9-16-99

Installed by: RANDY MILLER

Operation Permit by: STEVE HEDRICK date 9-23-99

Existing System Inspection by: date

HEALTH DEPT. COPY WHITE OWNER COPY (FINAL) YELLOW OWNER COPY (INITIAL) PINK