IREDELL COUNTY HEALTH DEPARTMENT

STATESVILLE 704-878-5305 MOORESVILLE 704-664-5281

IMPROVEMENT PERMIT / CERTIFICATE OF COMPLETION / OPERATION PERMIT / EXISTING SYSTEM INSPECTION

PROPERTY DESCRIPTION NO. 16560 DATE 6/28/93 TAX MAP NO. 12K-A-13

OWNER OR CONTRACTOR MILDRED J. KELLER PHONE: Business Home 546-2394

ADDRESS RT. 1, Box 297, HARMONY, NC 28634

LOCATION US 21 N TR, NC 901 E, ON (R) AT 2nd HOUSE PAST GUILFORD ROAD

SUBDIVISION BLOCK / SECTION LOT LOT AREA 1.4 Ac SITE CLASS. PS L.T.A.R. 0.35 GPD/FT²

Water Supply: ☐ Individual ☐ Community ☑ Public

Septic Tank: 1000 Gallons: STB 1012 Date 5/23/93

Pump Tank: Gallons: PT Date

Nitrification Field: No Fields 1 Square Feet 690 Linear Feet 230

No Lines 3 Trench Width 36" Trench Depth ≤36" Gravel Depth 12"

☑ New System ☐ Repair System Type: I, II, III, IV, V, VI

System Description: CONV., GRAVITY

Repair System Description: CONV, GRAVITY

Maintenance Agreement Required: ☑ Yes ☐ No

☐ House/Mod. Home ☑ Mobile Home ☐ Business ☐ Other

No. Bedrooms 2 No. Bathrooms 1 No. Employees

Garbage Disposal: ☐ Yes ☑ No

Auto. Dishwasher: ☐ Yes ☐ No


Auto. Washing Machine: ☐ Yes ☐ No

Other

☐ Slab ☑ Crawl Space ☐ Basement w/plumbing ☐ Basement wo/plumbing

Comments ① KEEP SYSTEM MINIMUM 5' FROM MH, 10' FROM PROPERTY LINE ② INSTALL LINES ON CONTOUR, NO DEEPER THAN 36", 9' ON CENTER

INITIAL SITE SKETCH

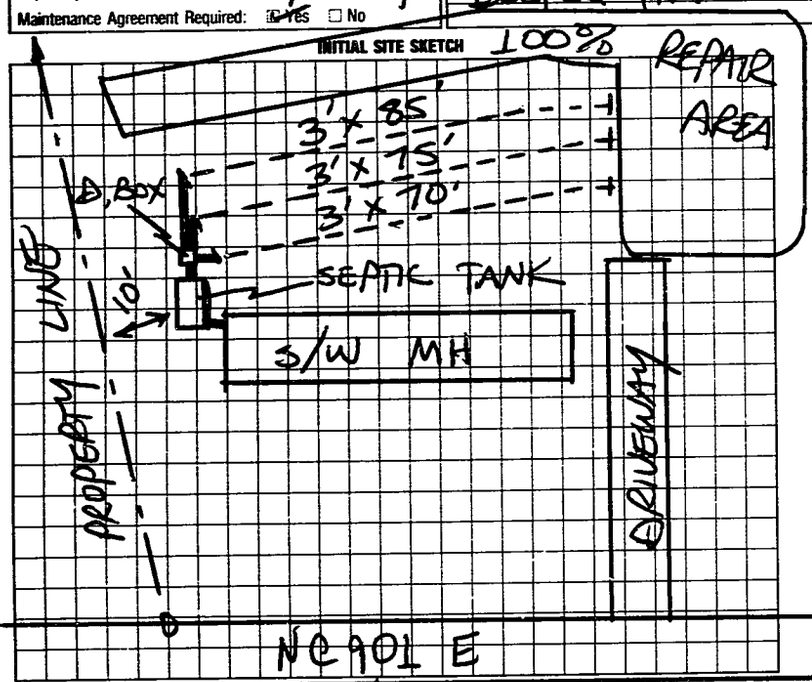

AS BUILT SKETCH

SYSTEM INSTALLED ACCORDING TO INITIAL SITE SKETCH

I understand that this permit can be suspended or revoked if any false information is supplied toward securing the permit/any unauthorized changes are made to the site/any unauthorized changes are made in the installation of the system. Improvement Permit is valid for 60 months from date of issuance.

Signed: X John R. Keller

Improvement Permit by: STEVE HEDRICK date 6/28/93

Existing System Inspection by: date

Installed by: HARRY REED

Certificate of Completion by: STEVE HEDRICK date 7/28/93

Operation Permit by: date

HEALTH DEPT. COPY: WHITE INSPECTION COPY (FINAL): GREEN OWNER COPY (FINAL): YELLOW INSPECTION COPY (INITIAL): PINK OWNER COPY (INITIAL): GOLD