IREDELL COUNTY HEALTH DEPARTMENT

STATESVILLE 704-878-5305 MOORESVILLE 704-664-5281

IMPROVEMENT PERMIT / AUTHORIZATION TO CONSTRUCT / OPERATION PERMIT / EXISTING SYSTEM INSPECTION

PERMIT# 123108 PIN# 4799-06-~~4070~~ 0839 DATE 8-3-04

OWNER OR CONTRACTOR DANNY W. KELLER PHONE: Business (704) 873-3335 Home (704) 546-2394

ADDRESS 1038 E. MEMORIAL HWY HARMONY 28634

LOCATION I-77N ® NC 901 2ND HOUSE PAST GUILFORD ON RIGHT

SUBDIVISION _____ BLOCK / SECTION _____ LOT _____ LOT AREA 2.12 SITE CLASS. PS DESIGN FLOW 240 L.T.A.R. EX.

Septic Tank: EX 1000 Gallons; STB _____ Date _____
Pump Tank: _____ Gallons; PT _____ Date _____
Pump Make: _____ Model _____ Serial No. _____
Nitrification Field: No Fields 1 Square Feet _____ Linear Feet EX. 230
No Lines 3 EX. Trench Width _____ Max Trench Bottom Depth _____ Gravel Depth _____

☐ New System ☐ Repair System Type: I, (II), III, IV, V, VI
System Description: CONV. GRAVITY
Repair System Description: SAME
Maintenance Agreement Required: ☐ Yes ☑ No

☐ House/Mod. Home No. Bedrooms 2
☑ Mobile Home No. Bathrooms 1
☐ Business No. Employees _____
☐ Other _____


☐ Slab ☑ Crawl Space ☐ Basement w/plumbing ☐ Basement wo/plumbing

Water Supply: ☐ Individual ☑ Public ☐ Community


Comments:/Conditions:

Comments:/Conditions: (1) SYSTEM FUNCTIONING PROPERLY AT TIME OF INSPECTION (2) PERMISSION TO CONNECT NEW STRUCTURE TO SYSTEM (3) NEW STRUCTURE SHALL NOT INCREASE NO. OF BEDROOMS ON SYSTEM (4) VISUAL INSPECTION ONLY - NO GUARANTEE PROBLEM WON'T RISE IN FUTURE.

INITIAL SITE SKETCH SCALE 1"=50'

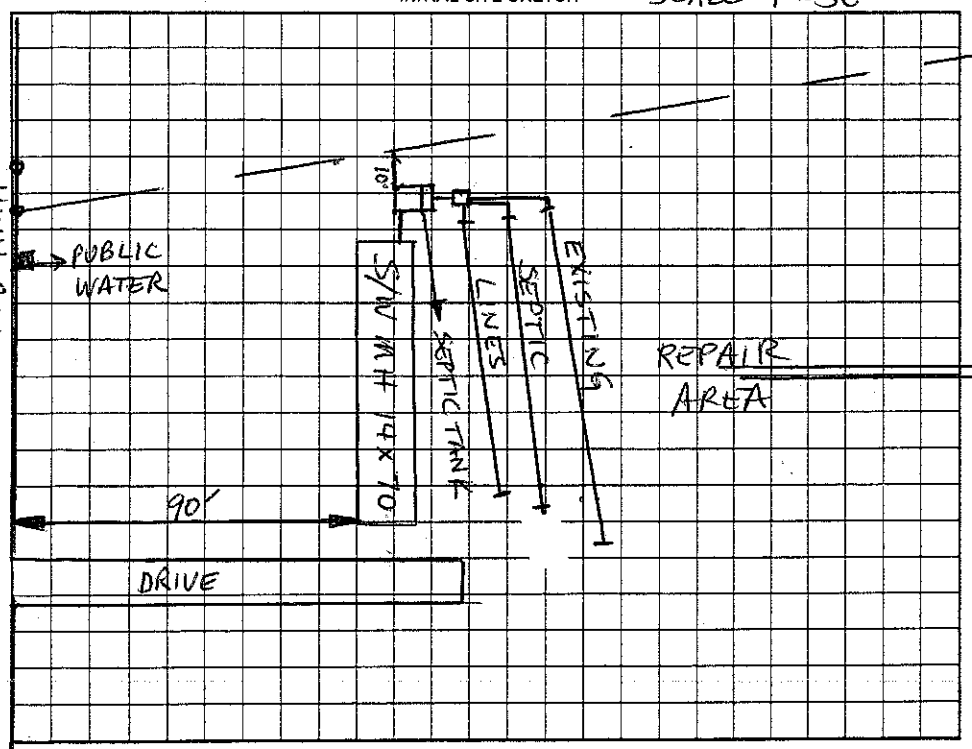

AS BUILT SKETCH

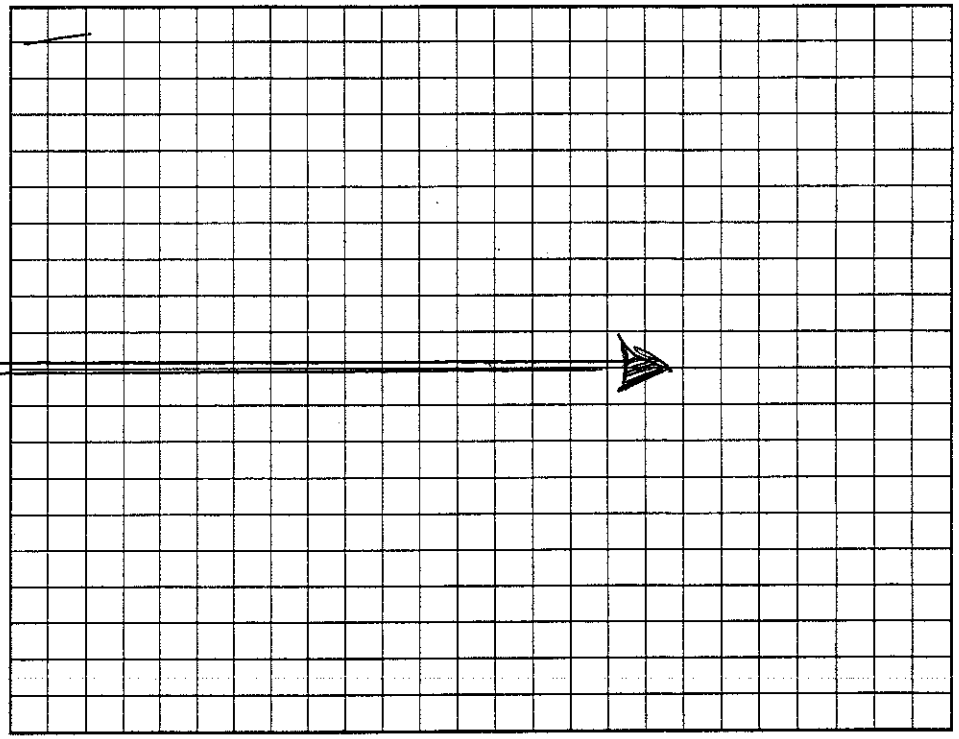

Permit can be suspended or revoked if any false information is supplied toward securing the permit/any unauthorized changes are made to the site/any unauthorized changes are made in the installation of the system. Improvement Permit with plat valid without expiration. Improvement Permit with site plan valid for sixty months. Authorization to Construct is valid for a period equal to that of Improvement Permit – not to exceed sixty months.

Signed: Danny Keller date 8-3-04 Installed by: HARRY REED

Improvement Permit by: _____ date _____ Operation Permit by: _____ date _____

Authorization to Construct by: _____ date _____ Existing System Inspection by: Christopher M. Shue, LS date 8-3-04

HEALTH DEPT. COPY: WHITE OWNER COPY (FINAL): YELLOW OWNER COPY (INITIAL): PINK