IREDELL COUNTY HEALTH DEPARTMENT

STATESVILLE 704-878-5305 MOORESVILLE 704-664-5281

IMPROVEMENT PERMIT / CERTIFICATE OF COMPLETION / OPERATION PERMIT / EXISTING SYSTEM INSPECTION

PROPERTY DESCRIPTION NO. 17025 DATE 9/20/93 TAX MAP NO. 12K-1-A-3

OWNER OR CONTRACTOR MIKE TEMPLETON PHONE: Business Home 873-1014

ADDRESS RT. 5, BOX A-107, STVL, NC 28677

LOCATION NC 901 EAST FROM US 21, 3RD LOT ON (R) PAST GUILFORD ROAD

SUBDIVISION EMILY STROUD VICK BLOCK / SECTION LOT 3 LOT AREA 125 x ~200 SITE CLASS. PS L.T.A.R. 0.35 GPD/FT2

Water Supply: ☐ Individual ☐ Community ☑ Public

Septic Tank: 1000 Gallons; STB 358 Date 10/12/93

Pump Tank: Gallons; PT Date

Nitrification Field: No Fields 1 Square Feet 1035 Linear Feet 345

No Lines 3 Trench Width 36 Trench Depth 18-36" Gravel Depth 12

☑ New System ☐ Repair System Type: I, II, III, IV, V, VI

System Description: CONV. GRAVITY

Repair System Description: CONV. PUMP

Maintenance Agreement Required: ☐ Yes ☑ No

☐ House/Mod. Home ☑ Mobile Home ☐ Business ☐ Other

No. Bedrooms 3 No. Bathrooms 2 No. Employees

Garbage Disposal: ☐ Yes ☑ No

Auto. Dishwasher: ☐ Yes ☐ No


Auto. Washing Machine: ☑ Yes ☐ No

Other

☐ Slab ☑ Crawl Space ☐ Basement w/plumbing ☐ Basement wo/plumbing

Comments (1) KEEP SYSTEM MINIMUM 5' FROM MH, 10' FROM PROPERTY LINE.
(2) INSTALL LINES ON CONTOUR, NO DEEPER THAN 36", 9' APART O.C.

INITIAL SITE SKETCH

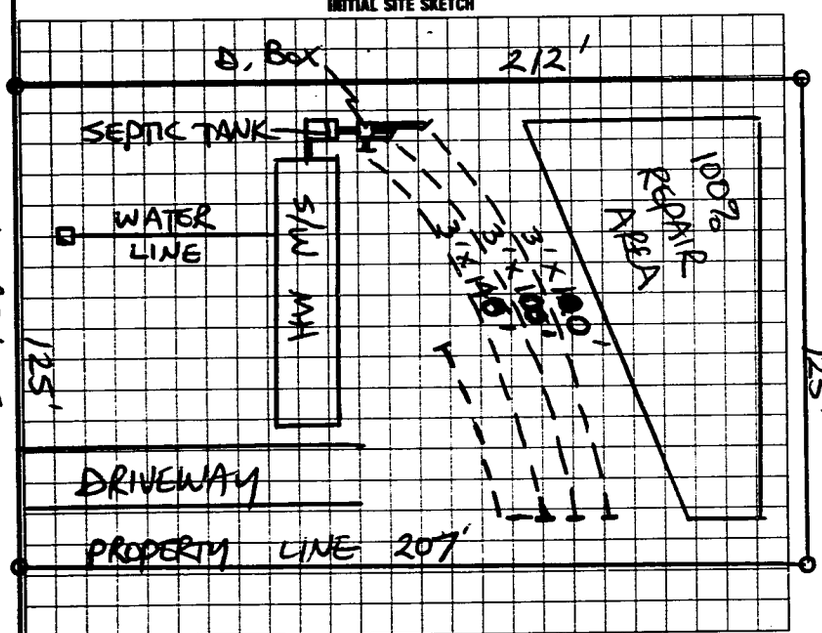

AS BUILT SKETCH

SYSTEM INSTALLED ACCORDING TO INITAL SITE SKETCH

I understand that this permit can be suspended or revoked if any false information is supplied toward securing the permit/any unauthorized changes are made to the site/any unauthorized changes are made in the installation of the system. Improvement Permit is valid for 60 months from date of issuance.

Signed: X Mike Templeton

Improvement Permit by: STEVE HEDRICK date 9/20/93

Existing System Inspection by: date

Installed by: A-1 BACKHOE

Certificate of Completion by: STEVE HEDRICK date 10/12/93

Operation Permit by: date

HEALTH DEPT. COPY: WHITE INSPECTION COPY (FINAL): GREEN OWNER COPY (FINAL): YELLOW INSPECTION COPY (INITIAL): PINK OWNER COPY (INITIAL): GOLD