IREDELL COUNTY HEALTH DEPARTMENT

STATESVILLE 704-878-5305 MOORESVILLE 704-664-5281

IMPROVEMENT PERMIT / AUTHORIZATION TO CONSTRUCT / OPERATION PERMIT / EXISTING SYSTEM INSPECTION

PERMIT# 083785 PIN# 4799 06 6887 DATE 9-22-99

OWNER OR CONTRACTOR SHELBY MUSE PHONE: Business Home (410) 532-6890

ADDRESS 1312 CROFT ROAD, BALTIMORE MD, 21239

LOCATION US 21 N, TR NC 901 TL GUILFORD ROAD, 0.1 MILE ON RIGHT ~ 400' OFF ROAD

SUBDIVISION EMILY VICK BLOCK / SECTION LOT 11 LOT AREA 6.08 ACRES SITE CLASS PS DESIGN FLOW 480 L.T.A.R. 0.30 GPD/FT²

Septic Tank: 1000 Gallons; STB Date

Pump Tank: Gallons; PT Date

Pump Make: Model Serial No.

Nitrification Field: No Fields 1 Square Feet 1600 Linear Feet 540

No Lines SIX Trench Width 36" Max Trench Bottom Depth 36 Gravel Depth 12"

[X] New System [ ] Repair System Type: I (II) III IV V VI

System Description: CONVENTIONAL GRAVITY

Repair System Description: CONV. GRAVITY

Maintenance Agreement Required: [ ] Yes [X] No

[ ] House/Mod. Home [X] Mobile Home [ ] Business [ ] Other

No. Bedrooms 4 No. Bathrooms 2 No. Employees


[ ] Slab [X] Crawl Space [ ] Basement w/plumbing [ ] Basement wo/plumbing

Water Supply: [X] Individual [ ] Public OR [ ] Community

Comments/Conditions: REPAIR AREA

Comments/Conditions: SEPTIC TANK WITH RISERS INSTALLED USING "POLY LOK" FILTER

INITIAL SITE SKETCH

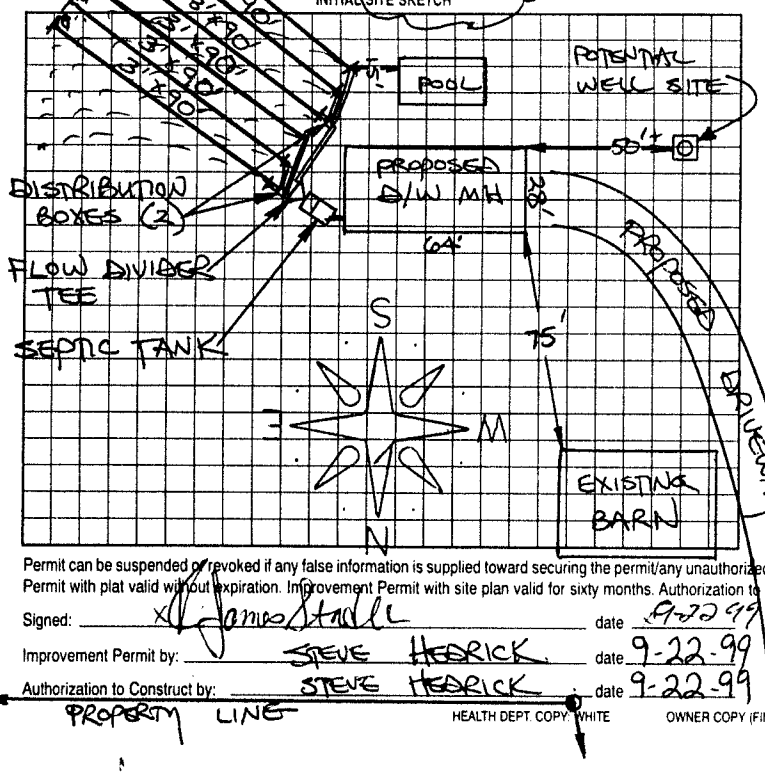

AS BUILT SKETCH

SYSTEM INSTALLED ACCORDING TO INITIAL SITE SKETCH

Permit can be suspended or revoked if any false information is supplied toward securing the permit/any unauthorized changes are made to the site/any unauthorized changes are made in the installation of the system. Improvement Permit with plat valid without expiration. Improvement Permit with site plan valid for sixty months. Authorization to Construct is valid for a period equal to that of Improvement Permit – not to exceed sixty months.

Signed: X James Stahl date 9-22-99 Installed by: A-1 BACKHOE

Improvement Permit by: STEVE HEDRICK date 9-22-99 Operation Permit by: STEVE HEDRICK date 9-23-99

Authorization to Construct by: STEVE HEDRICK date 9-22-99 Existing System Inspection by: date

PROPERTY LINE

HEALTH DEPT. COPY: WHITE OWNER COPY (FINAL): YELLOW OWNER COPY (INITIAL): PINK