IREDELL COUNTY HEALTH DEPARTMENT

STATESVILLE 704-878-5305 MOORESVILLE 704-664-5281

IMPROVEMENT PERMIT / CERTIFICATE OF COMPLETION / OPERATION PERMIT / EXISTING SYSTEM INSPECTION

PROPERTY DESCRIPTION NO. 21228 DATE 6/8/95 TAX MAP NO. 12L-1-A-2 Watershed: ☐ Yes ☒ No

OWNER OR CONTRACTOR DAVID ORR PHONE: Business 871-8609 Home 873-5291

ADDRESS 118 KIMBALL ST. STATESVILLE, NC 28677

LOCATION US 21 N, TR NC. 901, TL GUILFORD, TL FOX HUNTER, LOT ON LEFT ACROSS FROM PVT DRIVE

SUBDIVISION GRAY-FOX RACE BLOCK / SECTION ____ LOT 2 LOT AREA 13.4 AC SITE CLASS. PS DESIGN FLOW 360 L.T.A.R. 0.3 GPD/FT2

Septic Tank: 1000 Gallons; STB 1012 Date 5/20/96

Pump Tank: ____ Gallons; PT ____ Date ____

Pump Make: ____ Model ____ Serial No. ____

Nitrification Field: No Fields 1 Square Feet 1200 Linear Feet 400

No Lines 3 Trench Width 36" Max Trench Bottom Depth 18-36 Gravel Depth 12"

☒ New System ☐ Repair System Type: I, II, III, IV, V, VI

System Description: CONVENTIONAL GRAVITY

Repair System Description: CONV. GRAVITY

Maintenance Agreement Required: ☐ Yes ☒ No

☒ House/Mod. Home No. Bedrooms 3

☐ Mobile Home No. Bathrooms 2

☐ Business No. Employees ____

☐ Other ____

☐ Slab ☒ Crawl Space ☐ Basement w/plumbing ☐ Basement wo/plumbing

Water Supply: ☐ Individual ☐ Community ☐ Public WELL


Comments: ① KEEP SYSTEM MINIMUM 100' FROM WELL 5' FROM HOUSE ② INSTALL LINES AS SHOWN ON CONTOUR NO DEEPER THAN 36" 9' APART MIN. ON CENTER

Comments:


GRAVES ROAD

FOX HUNTER ROAD (SR 2128)

INITIAL SITE SKETCH

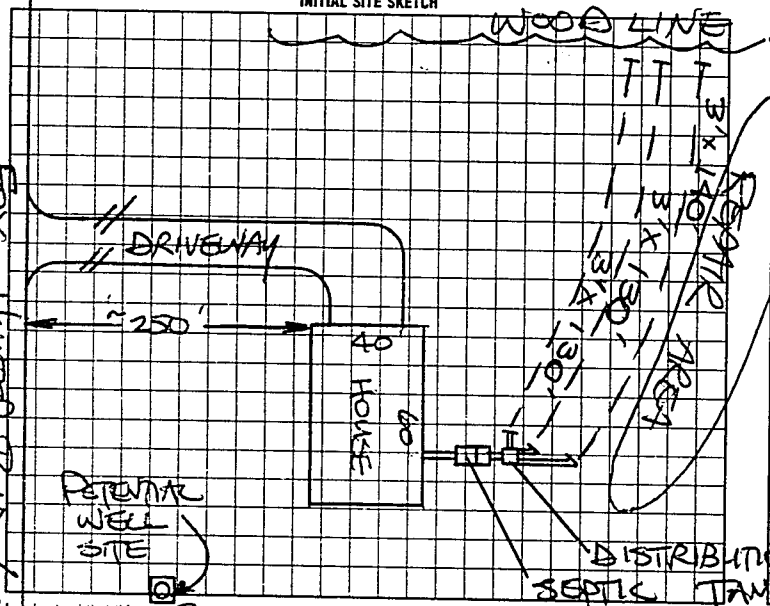

AS BUILT SKETCH

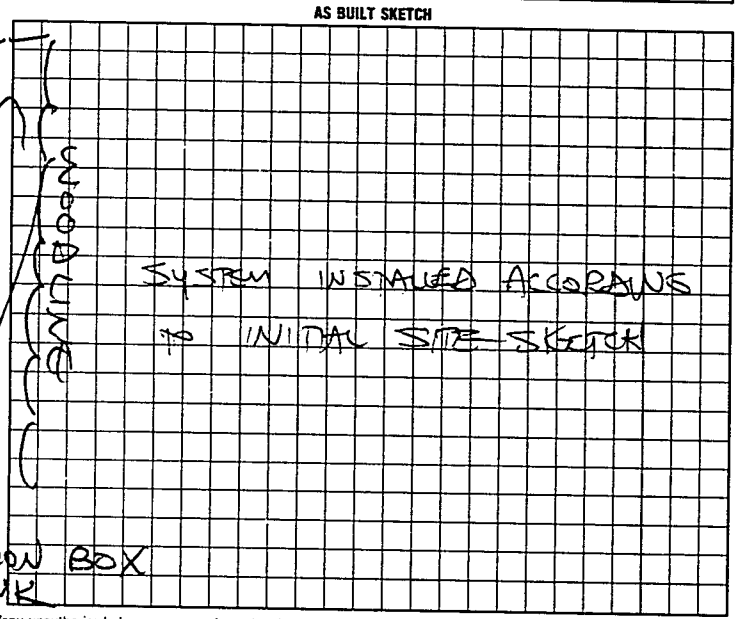

I understand that this permit can be suspended or revoked if any false information is supplied toward securing the permit/any unauthorized changes are made to the site/any unauthorized changes are made in the installation of the system. Improvement Permit is valid for 60 months from date of issuance.

Signed: X

Improvement Permit by: STEVE HEDRICK date 6/8/95

Existing System Inspection by: ____ date ____

Installed by: KENNY PEARSON

Certificate of Completion by: ____ date ____

Operation Permit by: STEVE HEDRICK date 8-27-96

HEALTH DEPT COPY WHITE INSPECTION COPY (FINAL) GREEN OWNER COPY (FINAL) YELLOW INSPECTION COPY (INITIAL) PINK OWNER COPY (INITIAL) GOLD