IREDELL COUNTY HEALTH DEPARTMENT

STATESVILLE 704-878-5305 MOORESVILLE 704-664-5281

IMPROVEMENT PERMIT / AUTHORIZATION TO CONSTRUCT / OPERATION PERMIT / EXISTING SYSTEM INSPECTION

PERMIT# 0884468 PIN# 4799 10 9928 DATE 4-24-00

OWNER OR CONTRACTOR KENNETH P. CARTNER, JR PHONE: Business Home 546-2849

ADDRESS 1315 E. MEMORIAL HWY, HARMONY, NC 28634

LOCATION OLD MOCKSVILLE ROAD NE, TR NC 901, 1ST HOUSE ON LEFT

SUBDIVISION BLOCK / SECTION LOT LOT AREA 1.65 ACRES SITE CLASS PS DESIGN FLOW 480 L.T.A.R. .30 gpd/ft²

Septic Tank: EXISTING Gallons: STB Date

Pump Tank: Gallons: PT Date

Pump Make: Model Serial No

Nitrification Field: No Fields 1 Square Feet 810 Linear Feet 270

No Lines TWO Trench Width 36" Max Trench Bottom Depth 36" Gravel Depth 12"

☑ New System ☐ Repair System Type: I (II) III IV V VI

System Description: CONVENTIONAL GRAVITY

Repair System Description: CONV. GRAVITY

Maintenance Agreement Required: ☐ Yes ☑ No

☑ House/Mod. Home ☐ Mobile Home ☐ Business ☐ Other

No. Bedrooms 4 No. Bathrooms 3 No. Employees


☐ Slab ☐ Crawl Space ☐ Basement w/plumbing ☑ Basement wo/plumbing

Water Supply: ☐ Individual ☑ Public ☐ Community


Comments/Conditions: INSTALL NEW LINES BY INTERSECTING EXISTING LINE, STEP-DOWN INTO NEW LINES

Comments/Conditions: Recommend having Tank pumped + outlet baffled, inspected, replace w/ SANITARY Tee if needed

INITIAL SITE SKETCH ~ SCALE: 1"=50'

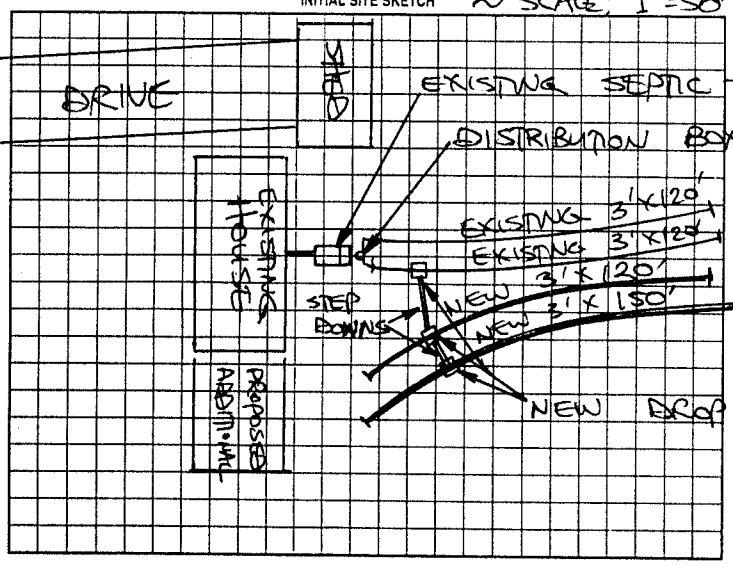

AS BUILT SKETCH

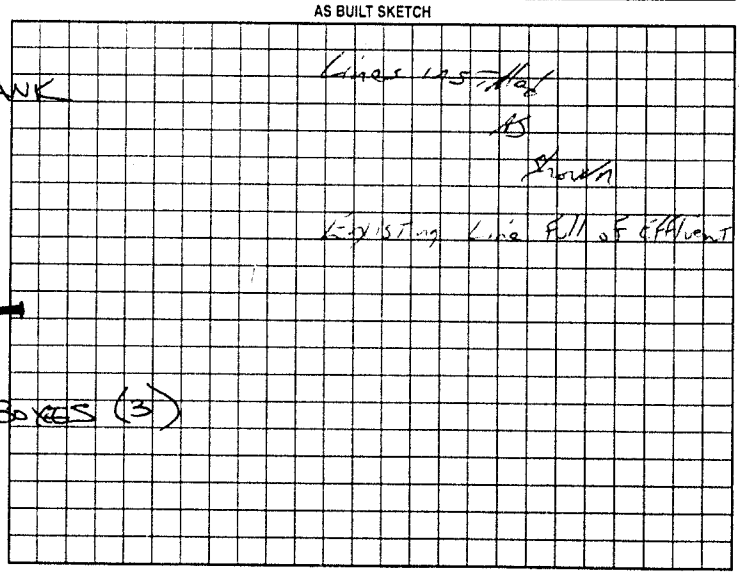

Permit can be suspended or revoked if any false information is supplied toward securing the permit/any unauthorized changes are made to the site/any unauthorized changes are made in the installation of the system. Improvement Permit with plat valid without expiration. Improvement Permit with site plan valid for sixty months. Authorization to Construct is valid for a period equal to that of Improvement Permit – not to exceed sixty months.

Signed: Kenny Cartner date 4-24-2000 Installed by: Tommy BEAVIS

Improvement Permit by: STEVE HEDRICK date 4-24-00 Operation Permit by: date 5/5/2000

Authorization to Construct by: STEVE HEDRICK date 4-24-00 Existing System Inspection by: date

HEALTH DEPT. COPY: WHITE OWNER COPY (FINAL) YELLOW OWNER COPY (INITIAL) PINK