IREDELL COUNTY HEALTH DEPARTMENT

STATESVILLE 704-878-5305 MOORESVILLE 704-664-5281

IMPROVEMENT PERMIT / AUTHORIZATION TO CONSTRUCT / OPERATION PERMIT / EXISTING SYSTEM INSPECTION

PERMIT# REPAIR PIN# 4799-11-3599 DATE 5-5-03

OWNER OR CONTRACTOR PLEASANTVIEW BAPT. CH PHONE: Business 704-546-7281 Home 704-546-2912

ADDRESS 1263 E. MEMORIAL HWY, HARMONY, NC 28634

LOCATION US 21 N, TR NC 901, ON LEFT JUST BEFORE OLD MOCKSVILLE ROAD AT # 1263

SUBDIVISION ____ BLOCK / SECTION ____ LOT ____ LOT AREA 3 ACRES SITE CLASS. PS DESIGN FLOW 240 L.T.A.R. EXISTING

Septic Tank EXISTING Gallons; STB ____ Date ____

Pump Tank: ____ Gallons; PT ____ Date ____

Pump Make: ____ Model ____ Serial No. ____

Nitrification Field: No Fields 1 Square Feet 375 Linear Feet 125

No Lines ONE Trench Width 36" Max Trench Bottom Depth 36" Gravel Depth 18"

☐ New System ☑ Repair System Type: I, II, III, IV, V, VI

System Description: CONVENTIONAL GRAVITY

Repair System Description: CONVENTIONAL GRAVITY

Maintenance Agreement Required: ☐ Yes ☑ No

☐ House/Mod. Home No. Bedrooms 2

☐ Mobile Home No. Bathrooms 1

☐ Business No. Employees ____

☐ Other ____


☐ Slab ☑ Crawl Space ☐ Basement w/plumbing ☐ Basement wo/plumbing

Water Supply: ☐ Individual ☑ Public ☐ Community

Comments/Conditions: SET NEW DISTRIBUTION BOX AS SHALLOW AS POSSIBLE FEEDING NEW LINE FIRST. USE 18 INCHES STONE IN NEW LINE

Comments/Conditions:

INITIAL SITE SKETCH

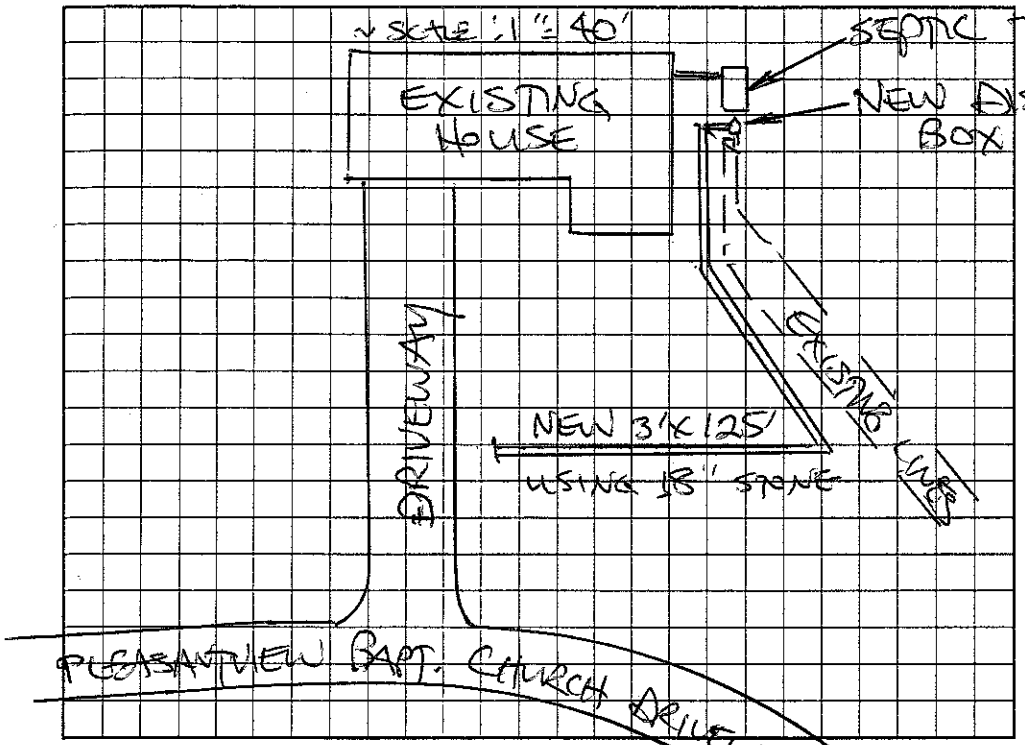

AS BUILT SKETCH

SYSTEM REPAIRED ACCORDING TO INITIAL SITE SKETCH

Permit can be suspended or revoked if any false information is supplied toward securing the permit/any unauthorized changes are made to the site/any unauthorized changes are made in the installation of the system. Improvement Permit with plat valid without expiration. Improvement Permit with site plan valid for sixty months. Authorization to Construct is valid for a period equal to that of Improvement Permit – not to exceed sixty months.

Signed: Melissa Jernigan (10 Pleasant View Baptist Church) date 5-5-03

Improvement Permit by: STEVE HENDRICK date 5-5-03

Authorization to Construct by: STEVE HENDRICK date 5-5-03

Installed by: TOMMY FRYE

Operation Permit by: STEVE HENDRICK date 5-30-03

Existing System Inspection by: ____ date ____

HEALTH DEPT. COPY: WHITE OWNER COPY (FINAL): YELLOW OWNER COPY (INITIAL): PINK